
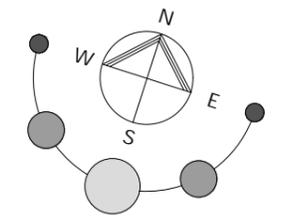


The Copyright of this drawing remains with Fulkers Bailey Russell and is not to be reproduced without written approval.

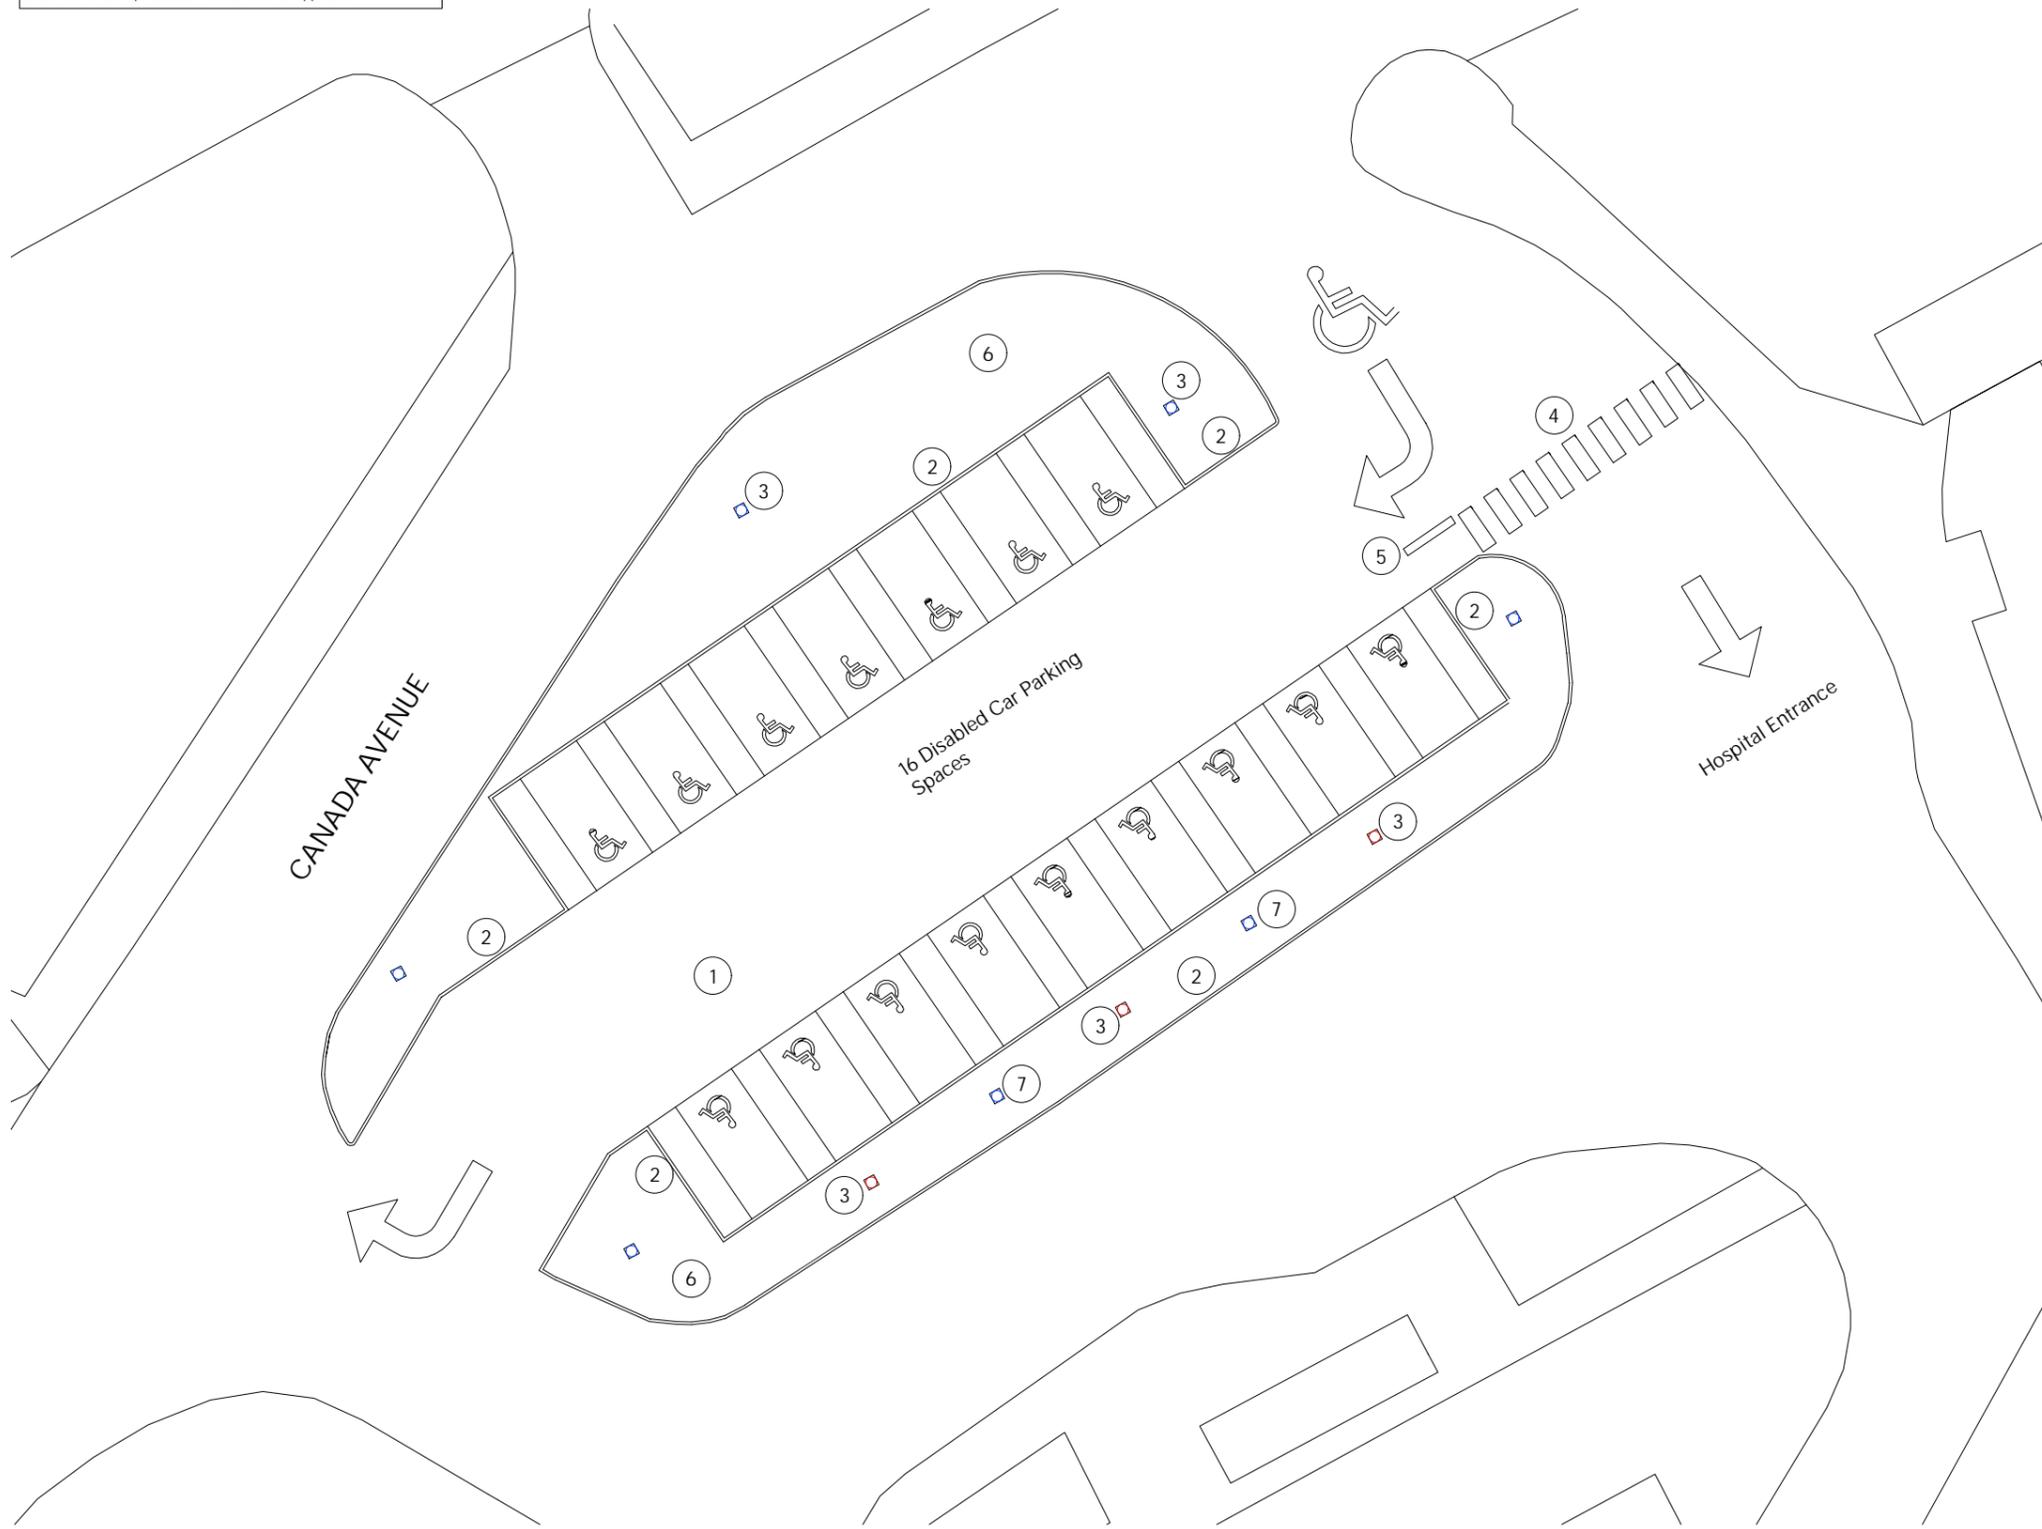

Disabled Car Park
Location Plan NTS

Disabled Car Park Plan
As Built

1:250

KEY TO MATERIALS	
1 Tarmacadam car park finish	5 Pedestrian safety barrier
2 Light grey concrete kerb	6 Grass
3 Light	7 Flag pole
4 Pedestrian crossing	



P01	Issued for Planning	24.06.22	AW
rev.	description	date	chkd.

client :
Surrey and Sussex NHS Trust

project :
**East Surrey Hospital
Canada Avenue Redhill, Surrey, RH1 5RH
Retrospective Planning Application**

drawing title :
**Disabled Car Park
Plan As Built**

Fulkers Bailey Russell

London | Brighton | Bristol | Leeds | Reading | Manchester
info@fulkers.co.uk // www.fulkers.co.uk // 020 3735 5792

drawn: CK	chkd: AW	date: June 2022
-----------	----------	-----------------

proj no : 22 3623	scale: 1:250 @ A3
--------------------------	----------------------

identifier :
3623-FBR-A11-GF-DR-A-255



status: S4 (For Planning)	rev no: P.01
-------------------------------------	-----------------



Overflow Car Park from East Staff Car Park
As Built

1:500

KEY TO MATERIALS	
①	Tarmacadam car park finish
②	Light grey concrete flush kerb
③	East Staff Car Park

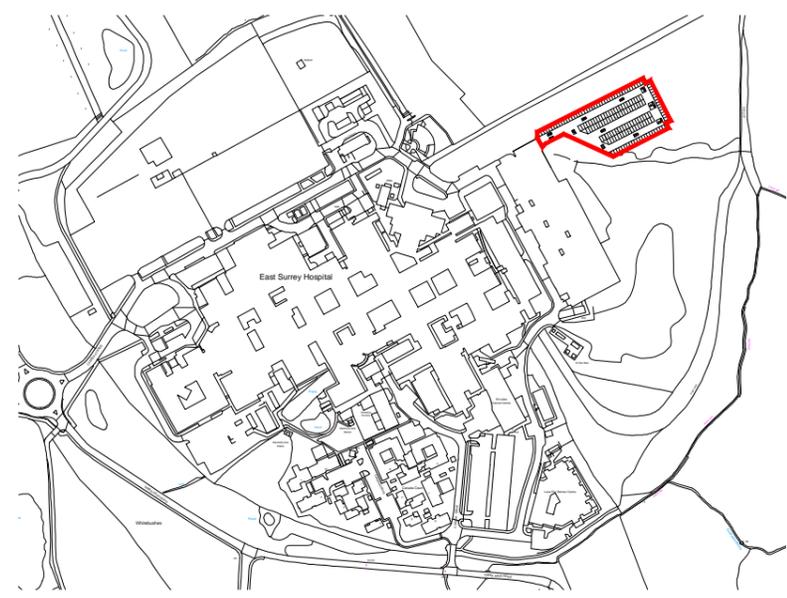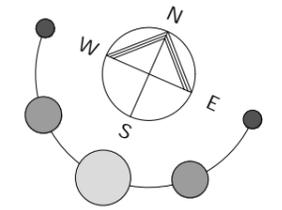

Overflow Car Park from East Staff Car Park
Location Plan

1:500

P01	Issued for Planning	24.06.22	AW
rev.	description	date	chkd.

client :
Surrey and Sussex NHS Trust

project :
**East Surrey Hospital
Canada Avenue Redhill, Surrey, RH1 5RH
Retrospective Planning Application**

drawing title :
**Overflow Car Park from East Staff Car Park
Plan As Built**

Fulkers Bailey Russell

London | Brighton | Bristol | Leeds | Reading | Manchester
info@fulkers.co.uk // www.fulkers.co.uk // 020 3735 5792




drawn: CK	chkd: AW	date: June 2022
-----------	----------	-----------------

proj no: 22 3623	scale: 1:500 @ A3
------------------	-------------------


identifier :
3623-FBR-A12-GF-DR-A-260

status: S4 (For Planning)	rev no: P.01
---------------------------	--------------




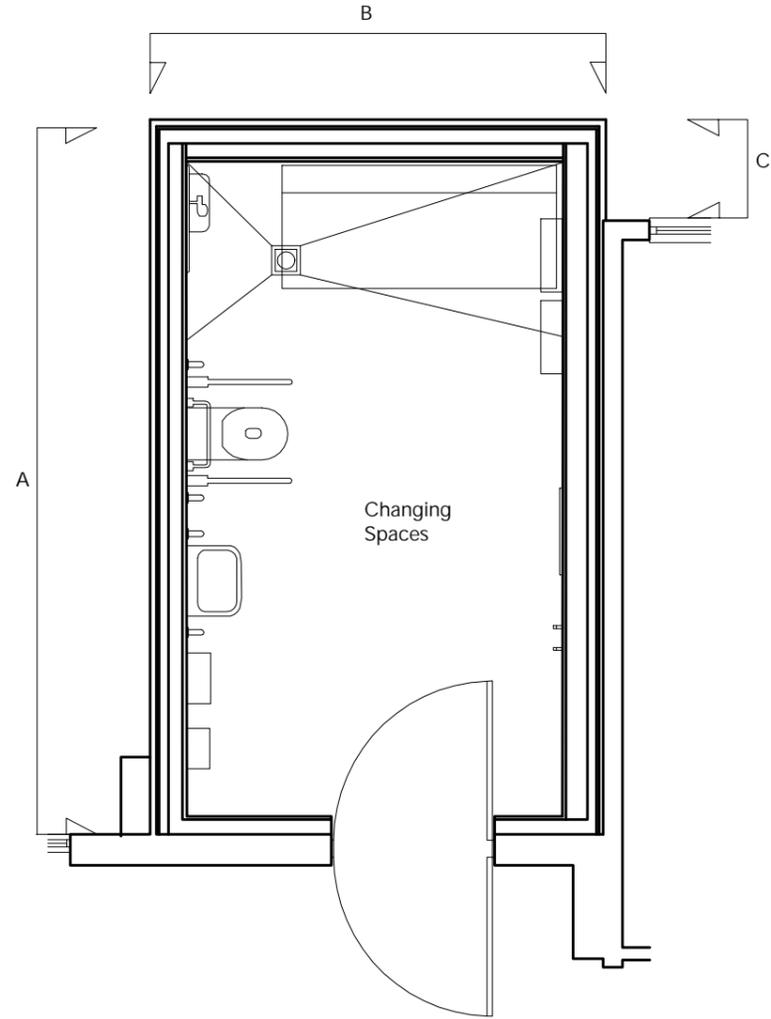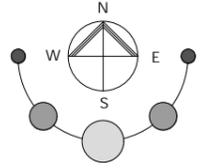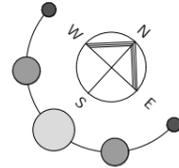


Plan of Changing Spaces
As Built 1:50

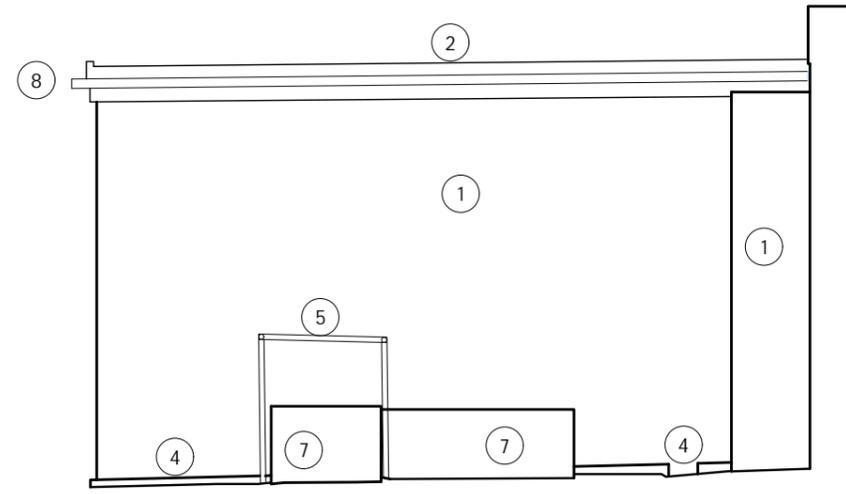

Elevation A
As Built 1:50

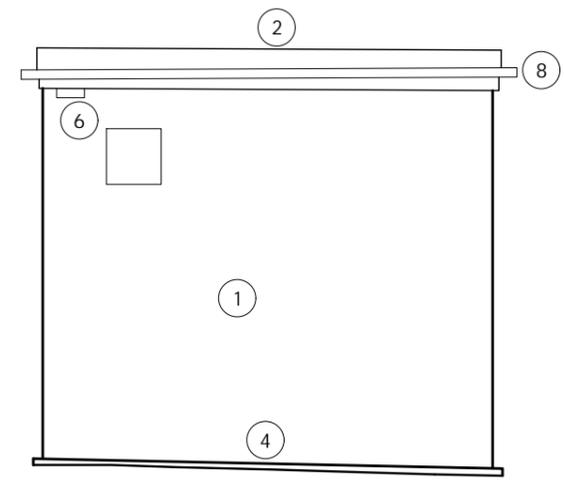


Elevation B
As Built 1:50

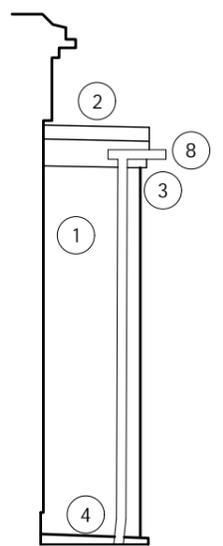

Elevation C
As Built 1:50

KEY TO MATERIALS	
1	Grey cladding
2	White flat roof
3	White RWP
4	Concrete kerb
5	Railing to protect timber access duct
6	Vents
7	Grey timber access duct to plumbing
8	White gutter

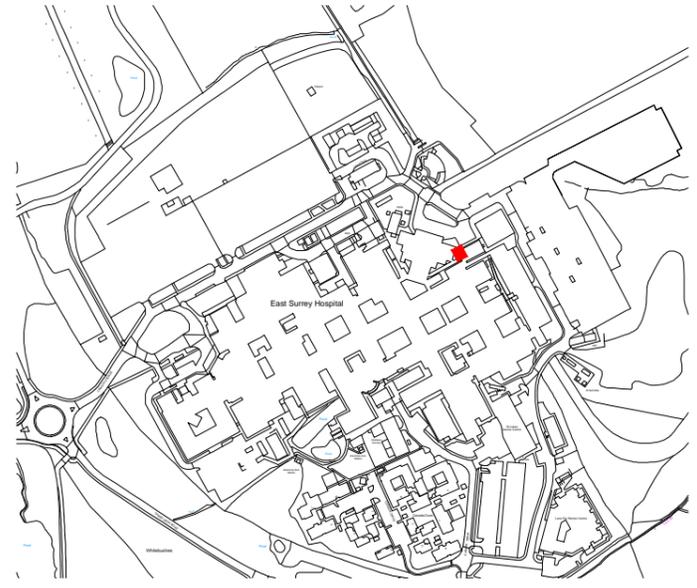

Changing Places
Location Plan NTS

rev.	description	date	chkd.
		24.06.22	AW

client :
Surrey and Sussex NHS Trust

project :
East Surrey Hospital
Canada Avenue Redhill, Surrey, RH1 5RH
Retrospective Planning Application

drawing title :
Building 15A : Changing Places
Plan and Elevations As Built

Fulkers Bailey Russell
London | Brighton | Bristol | Leeds | Reading | Manchester
info@fulkers.co.uk // www.fulkers.co.uk // 020 3735 5792




drawn: CK	chkd: AW	date: June 2022
-----------	----------	-----------------

proj no : 22 3623	scale: 1:50 @ A3
-------------------	------------------

identifier :
3623-FBR-A2-GF-DR-A-210


status: S4 (For Planning)	rev no: P.01
---------------------------	--------------



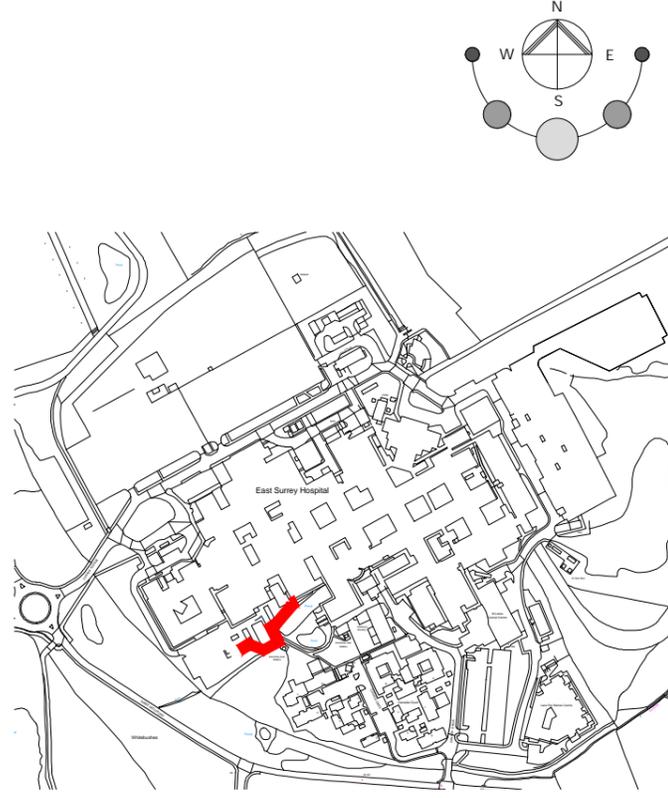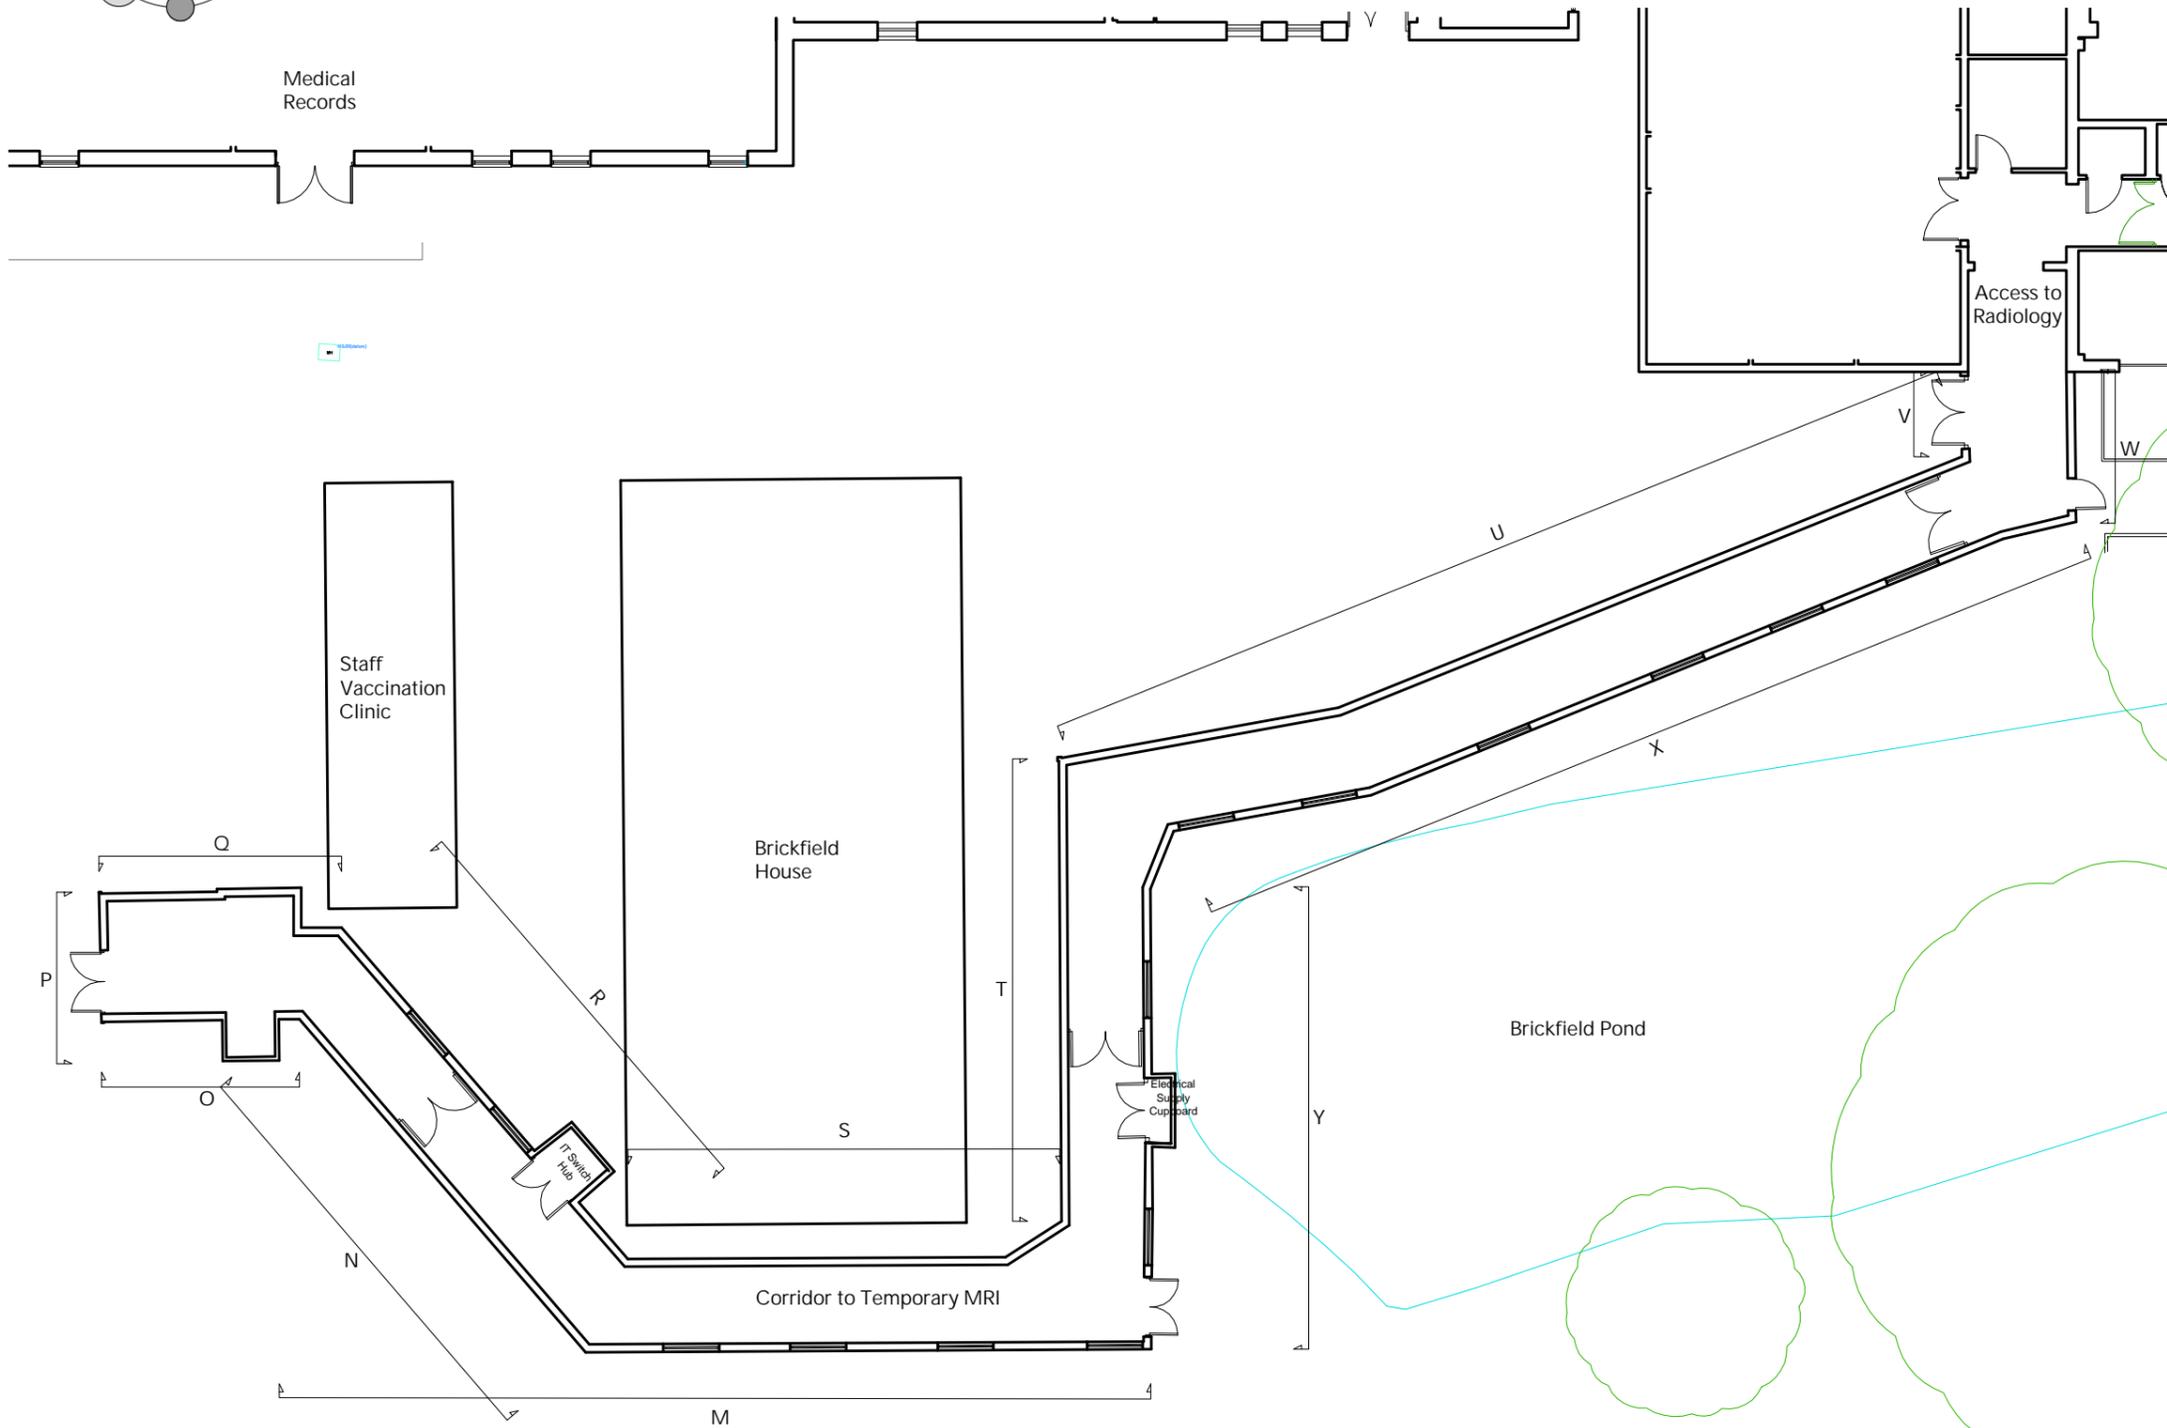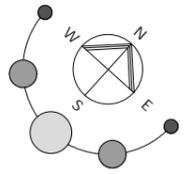

Corridor to Temporary MRI
Location Plan NTS

Plan of Corridor to Temporary MRI
As Built 1:200

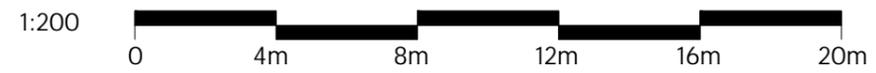

P01	Issued for Planning	24.06.22	AW
rev.	description	date	chkd.

client :
Surrey and Sussex NHS Trust

project :
**East Surrey Hospital
Canada Avenue Redhill, Surrey, RH1 5RH
Retrospective Planning Application**

drawing title :
**Building 34 : Corridor to Temporary MRI
Plan As Built**



Fulkers Bailey Russell
London | Brighton | Bristol | Leeds | Reading | Manchester
info@fulkers.co.uk // www.fulkers.co.uk // 020 3735 5792

drawn: CK	chkd: AW	date: June 2022
-----------	----------	-----------------


proj no: 22 3623	scale: 1:200 @ A3
------------------	-------------------

identifier :
3623-FBR-A3-GF-DR-A-215


status: S4 (For Planning)	rev no: P.01
---------------------------	--------------

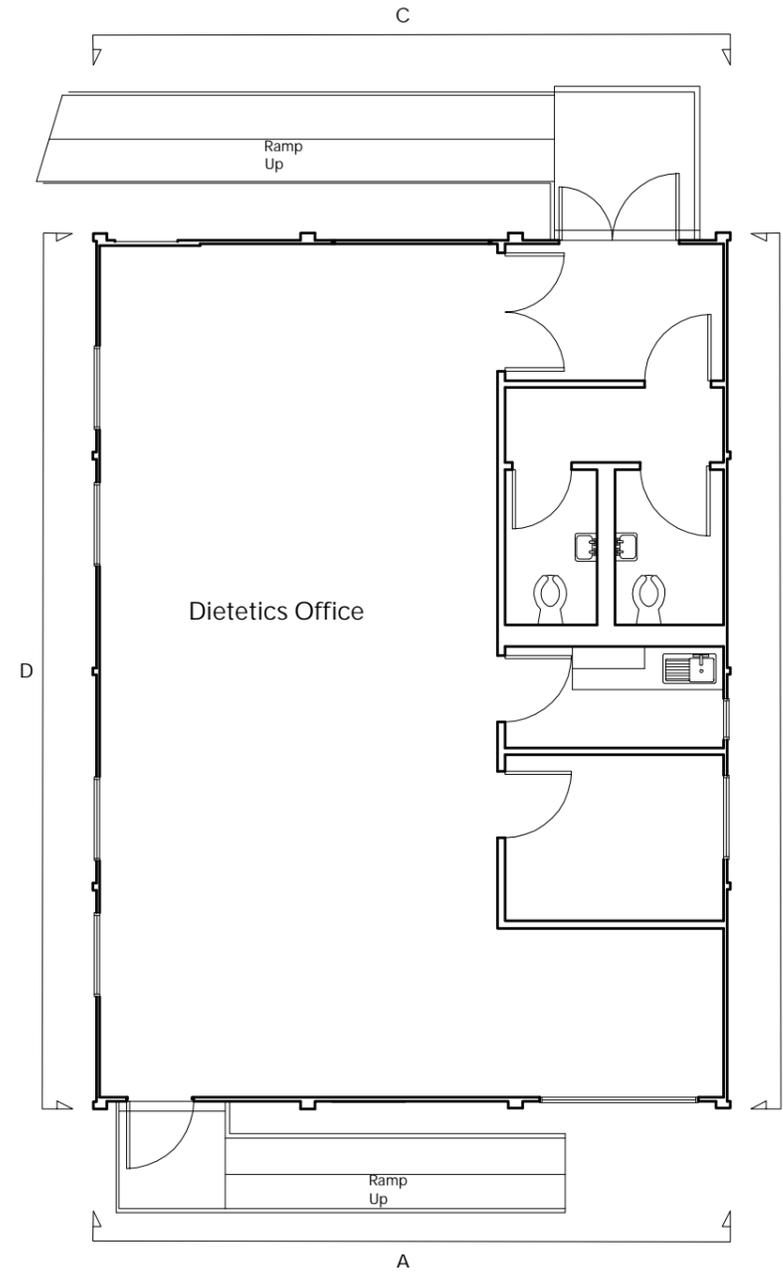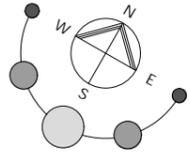


Dietetics Office Plan
As Built 1:100

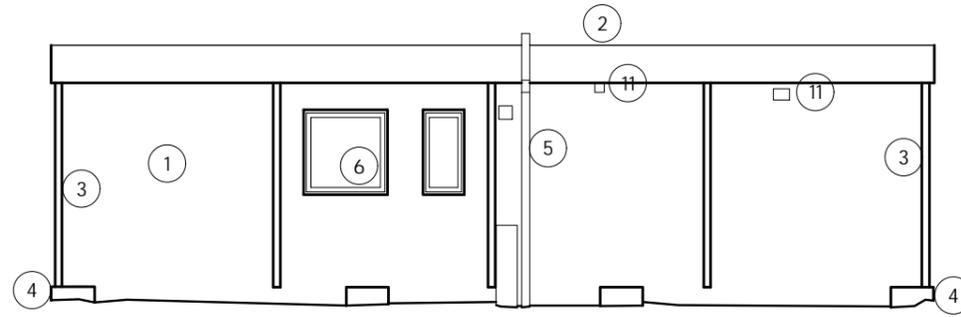


Elevation B of Dietetics Office
As Built 1:100

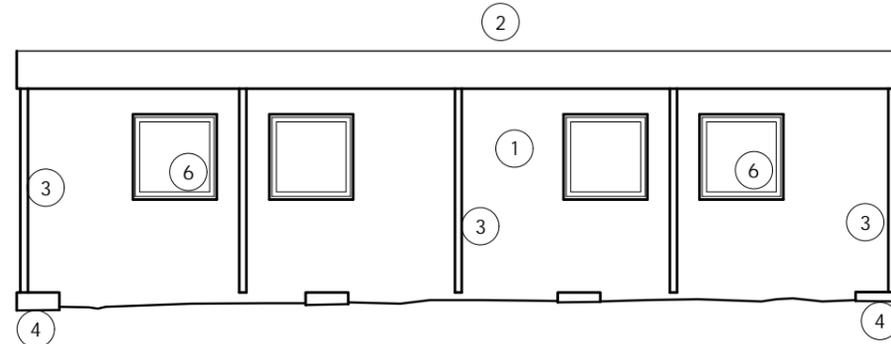

Elevation D of Dietetics Office
As Built 1:100

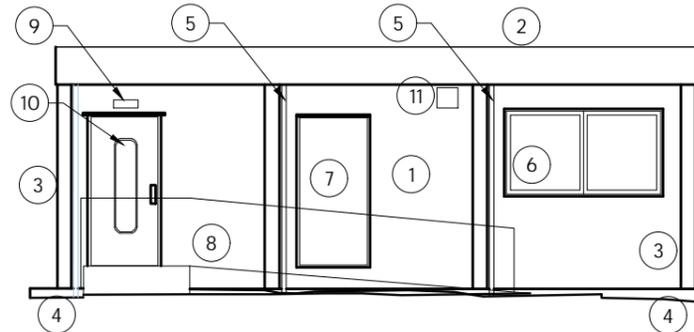



Elevation A of Dietetics Office
As Built 1:100

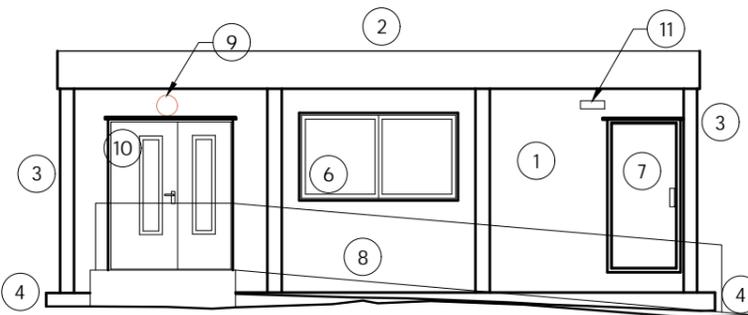

Elevation C of Dietetics Office
As Built 1:100

KEY TO MATERIALS

- 1 Light grey cladding
- 2 Grey flat roof
- 3 Metal support for modular building
- 4 Concrete support
- 5 Grey RWP
- 6 Dark grey double glazed windows
- 7 Grey spare door
- 8 Ramp with guardrail
- 9 Light
- 10 Grey entrance door
- 11 Vent

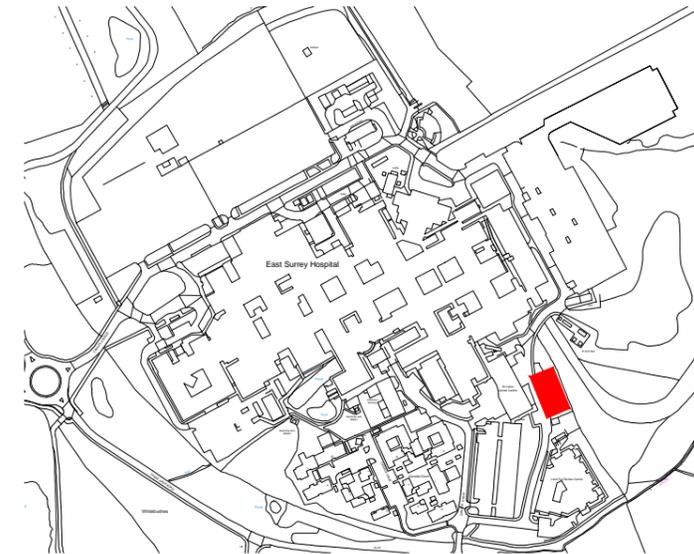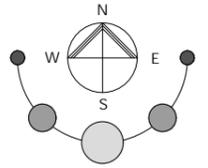

Dietetics Office
Location Plan NTS

P01	Issued for Planning	24.06.22	AW
rev.	description	date	chkd.

client :
Surrey and Sussex NHS Trust

project :
**East Surrey Hospital
Canada Avenue Redhill, Surrey, RH1 5RH
Retrospective Planning Application**

drawing title :
**Building 38 : Dietetics Office
Plan and Elevations As Built**

Fulkers Bailey Russell

London | Brighton | Bristol | Leeds | Reading | Manchester
info@fulkers.co.uk // www.fulkers.co.uk // 020 3735 5792



drawn: CK chkd: AW date: June 2022

proj no : **22 3623** scale: 1:100 @ A3

identifier :
3623-FBR-A7-GF-DR-A-235

status: **S4 (For Planning)** rev no: P.01



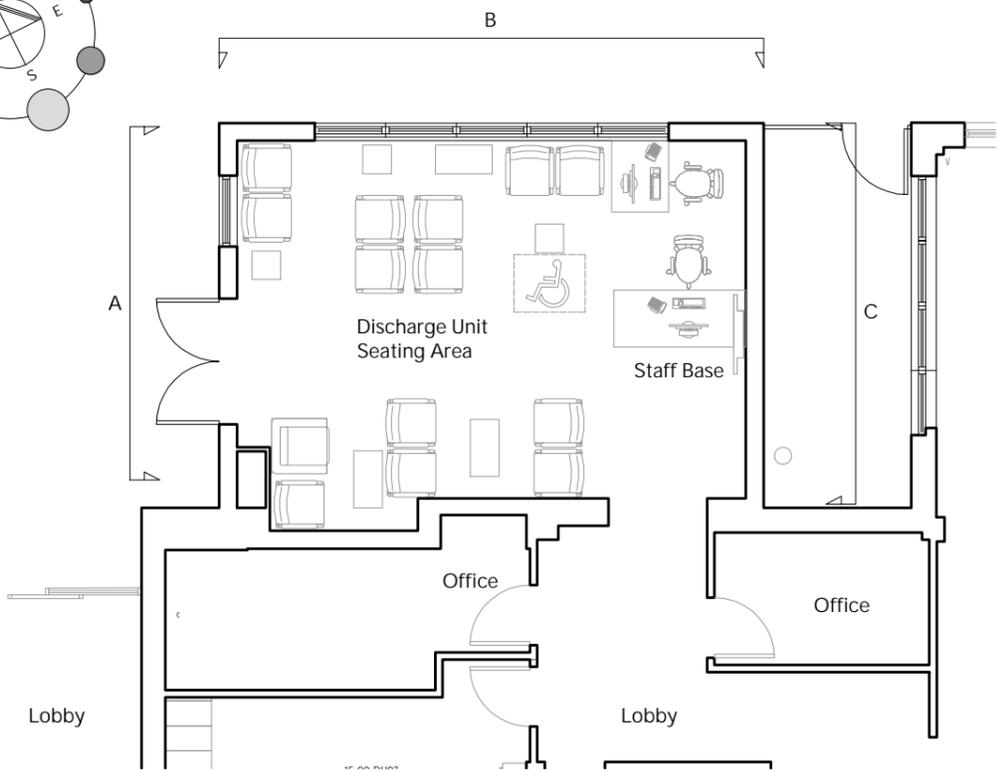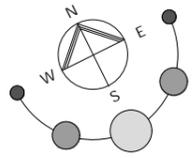


Plan of Discharge Unit
As Built

1:100

KEY TO MATERIALS


- 1 Rendered finish
- 2 Canopy
- 3 Column
- 4 Black double glazed windows
- 5 Black double glazed doors
- 6 Metal bollards
- 7 Metal beam
- 8 Vents

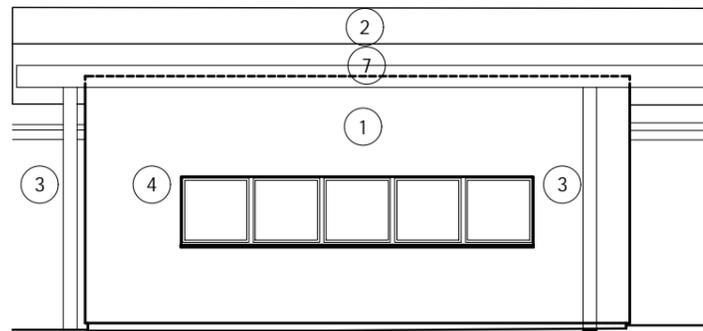

Elevation B

As Built


1:100

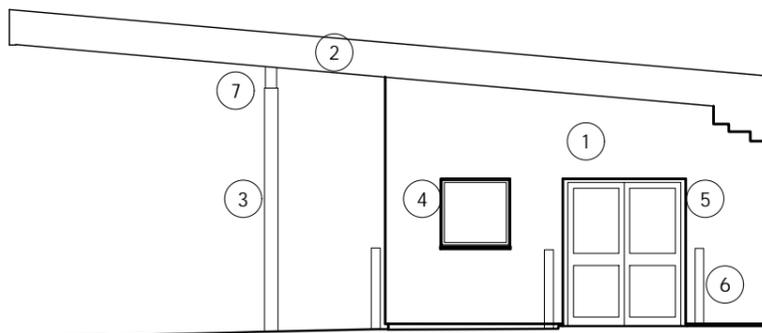

Elevation A

As Built



1:100

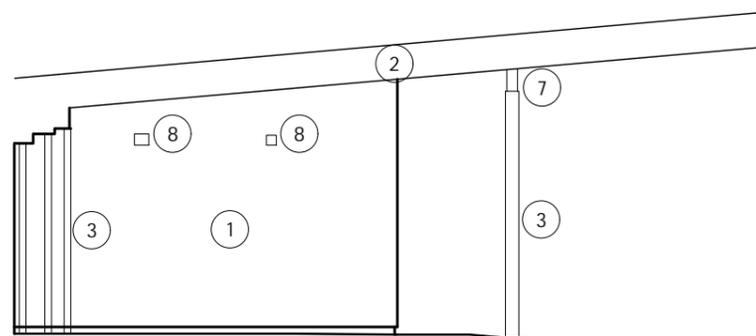

Elevation C

As Built

1:100

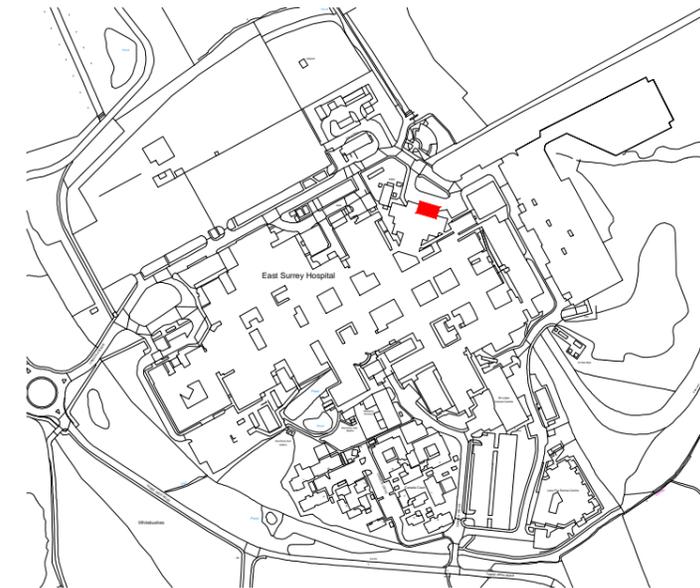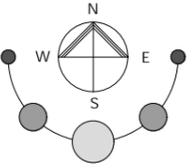

Discharge Unit Extension

Location Plan

NTS

P01	Issued for Planning	24.06.22	AW
rev.	description	date	chkd.

client :

Surrey and Sussex NHS Trust

project : East Surrey Hospital
Canada Avenue Redhill, Surrey, RH1 5RH
Retrospective Planning Application

drawing title :

Building 15 : Discharge Unit Extension
Plan and Elevations As Built

Fulkers Bailey Russell

london | brighton | bristol | leeds | reading | manchester
info@fulkers.co.uk // www.fulkers.co.uk // 020 3735 5792




drawn: CK	chkd: AW	date: June 2022
-----------	----------	-----------------

proj no : 22 3623	scale: 1:100 @ A3
-------------------	-------------------


identifier : 3623-FBR-A1-GF-DR-A-205

status: S4 (For Planning)	rev no: P.01
---------------------------	--------------




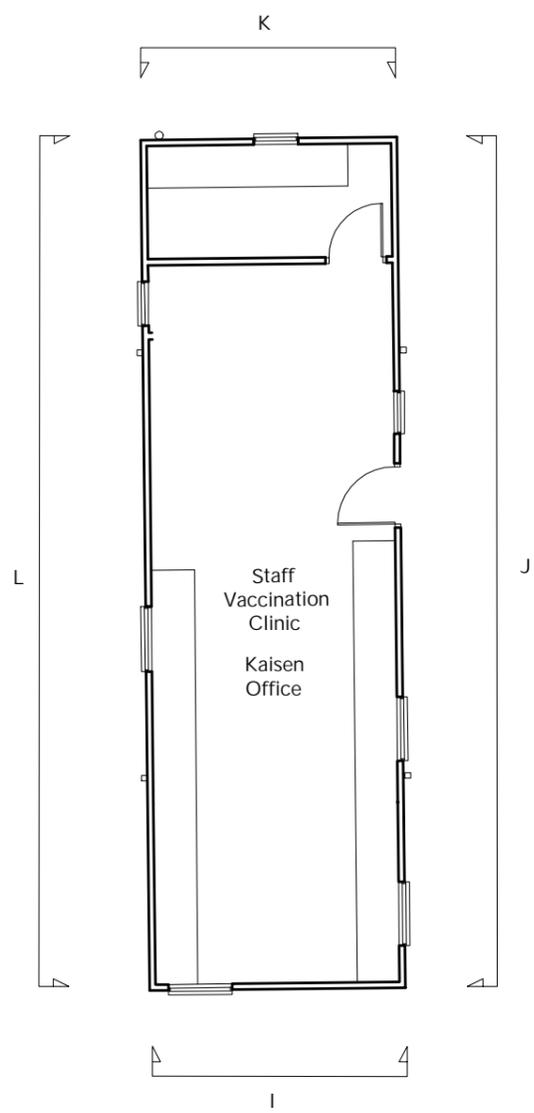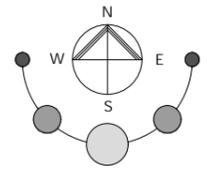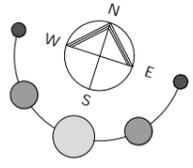


Plan of The Kaisen Office
As Built 1:100

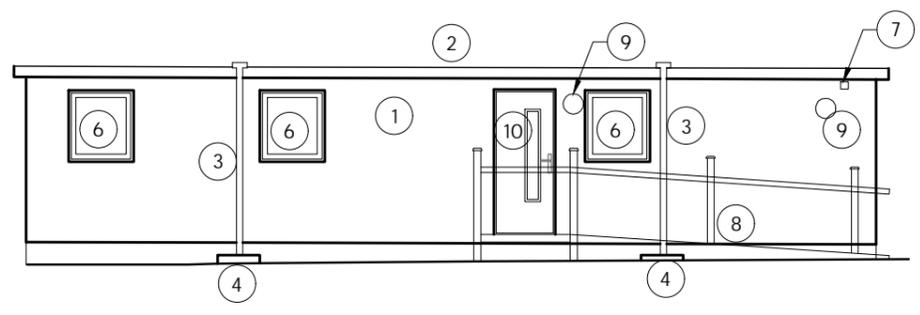


Elevation J of The Kaisen Office
As Built 1:100

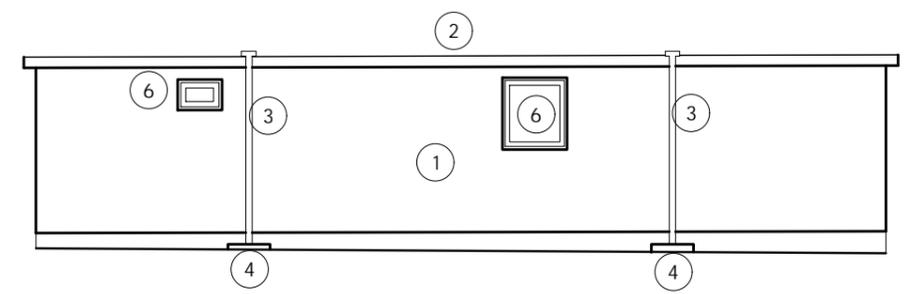

Elevation L of The Kaisen Office
As Built 1:100

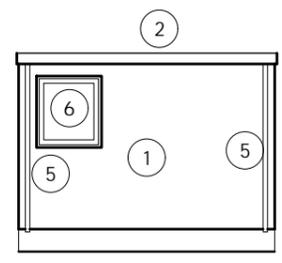


Elevation I of The Kaisen Office
As Built 1:100

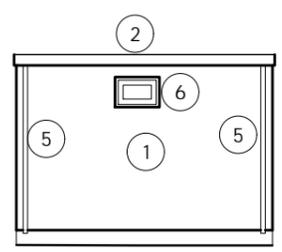

Elevation K of The Kaisen Office
As Built 1:100

KEY TO MATERIALS	
1	Light grey cladding
2	Grey flat roof
3	Metal support for modular building
4	Concrete support
5	White RWP
6	White double glazed windows
7	Electrical point
8	Ramp with guardrail
9	Light
10	Grey entrance door

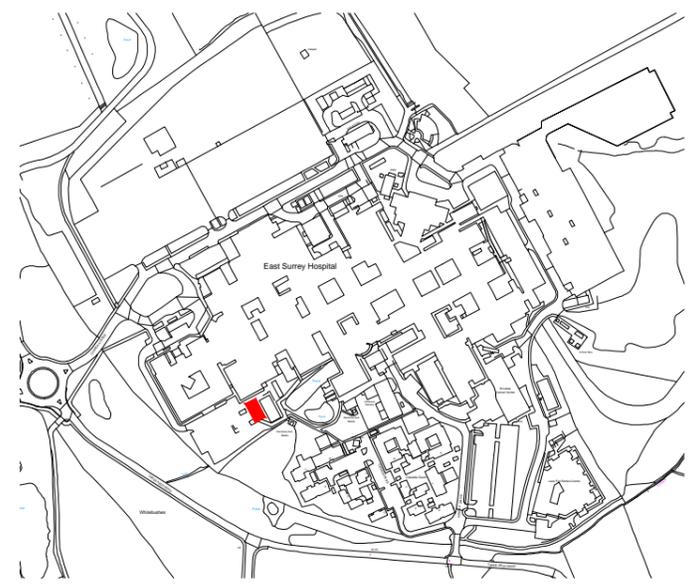

Kaisen Office
Location Plan NTS

P01 Issued for Planning	24.06.22	AW	
rev.	description	date	chkd.

client :
Surrey and Sussex NHS Trust

project :
**East Surrey Hospital
Canada Avenue Redhill, Surrey, RH1 5RH
Retrospective Planning Application**

drawing title :
**Building 35 : Kaisen Office
Plan and Elevations As Built**


Fulkers Bailey Russell
London | Brighton | Bristol | Leeds | Reading | Manchester
info@fulkers.co.uk // www.fulkers.co.uk // 020 3735 5792


drawn: CK	chkd: AW	date: June 2022
-----------	----------	-----------------

proj no : 22 3623	scale: 1:100 @ A3
-------------------	-------------------

identifier :
3623-FBR-A4-GF-DR-A-220

status: S4 (For Planning)	rev no: P.01
---------------------------	--------------

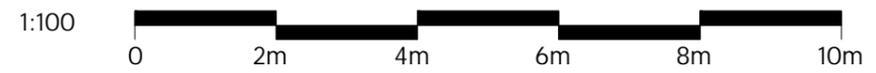


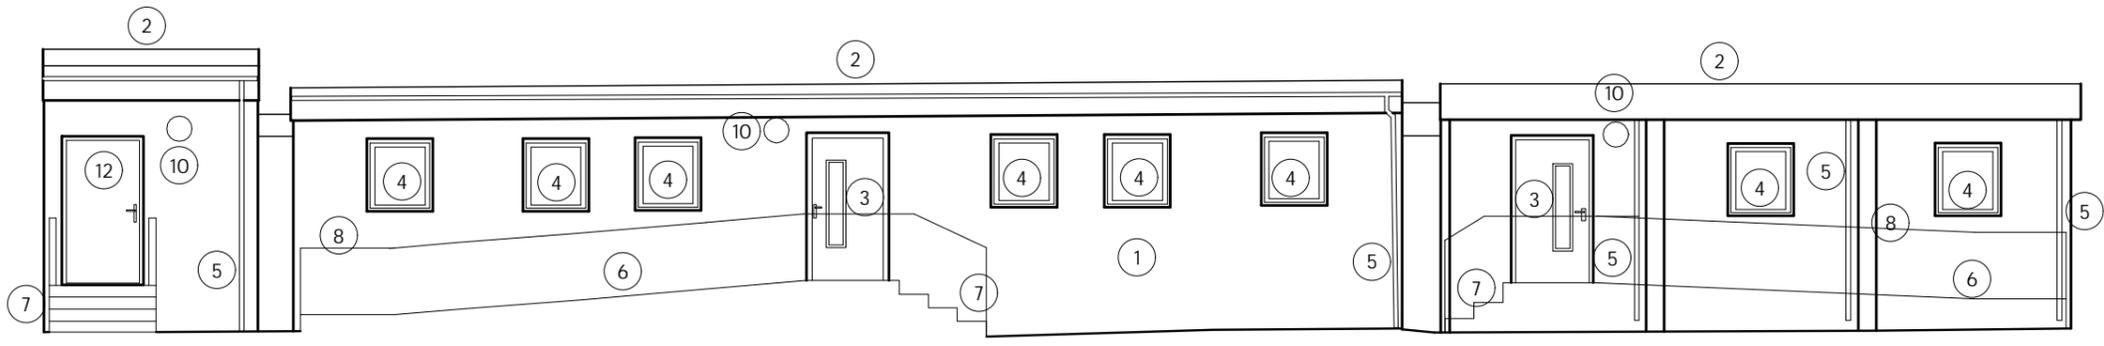

Elevation A

As Built


1:100

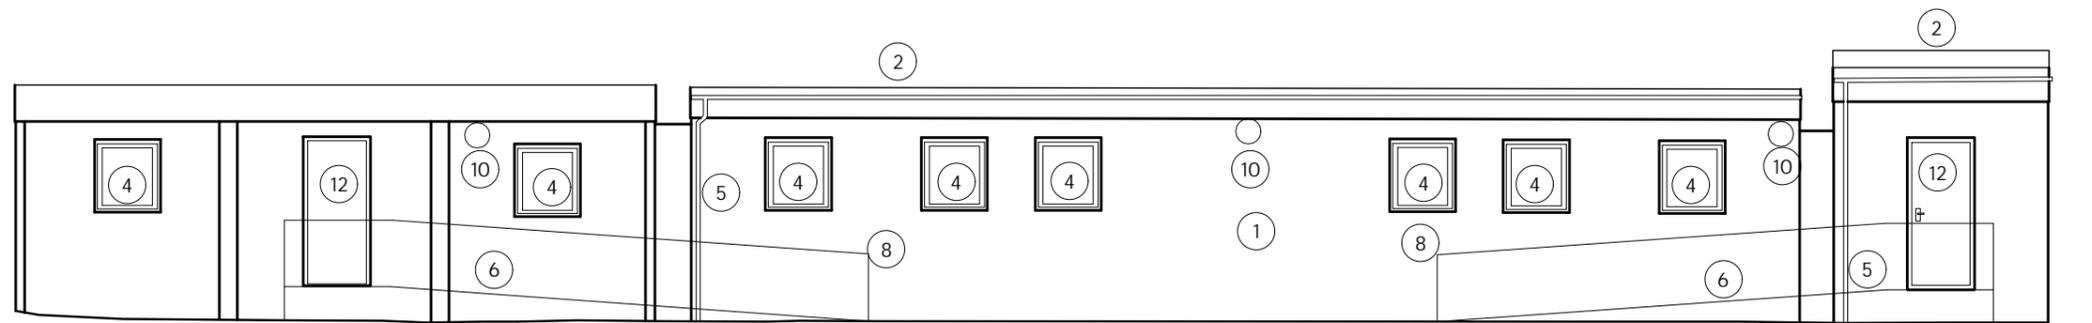

Elevation C

As Built


1:100

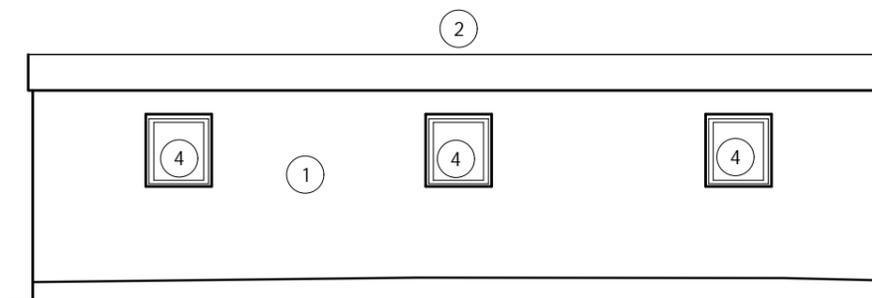

Elevation B

As Built

1:100

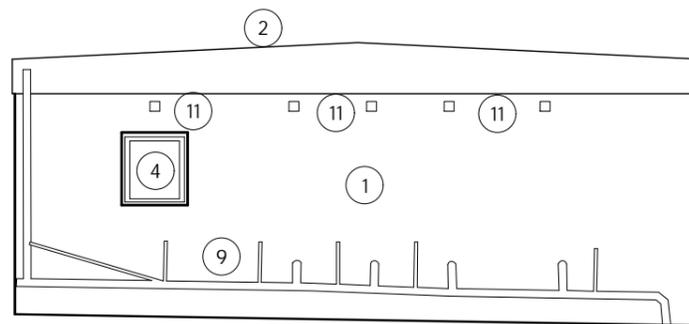

Elevation D

As Built

1:100

KEY TO MATERIALS

- ① Light green and grey cladding
- ② Dark grey flat roof
- ③ Dark grey entrance door
- ④ White double glazed windows
- ⑤ Dark grey rwp
- ⑥ Ramp
- ⑦ Stairs
- ⑧ Yellow guardrails
- ⑨ Pipework
- ⑩ Light
- ⑪ Vent
- ⑫ Fire escape door

P01	Issued for Planning	24.06.22	AW
rev.	description	date	chkd.

client :

Surrey and Sussex NHS Trust

project :

East Surrey Hospital
Canada Avenue Redhill, Surrey, RH1 5RH
Retrospective Planning Application

drawing title :

Building 41 : New Modular Building
Elevations As Built

Fulkers Bailey Russell

London | Brighton | Bristol | Leeds | Reading | Manchester
info@fulkers.co.uk // www.fulkers.co.uk // 020 3735 5792

drawn: CK	chkd: AW	date: June 2022
-----------	----------	-----------------





proj no: 22 3623	scale: 1:100 @ A3
------------------	-------------------

identifier :

3623-FBR-A10-GF-DR-A-251

status: S4 (For Planning)	rev no: P.01
---------------------------	--------------



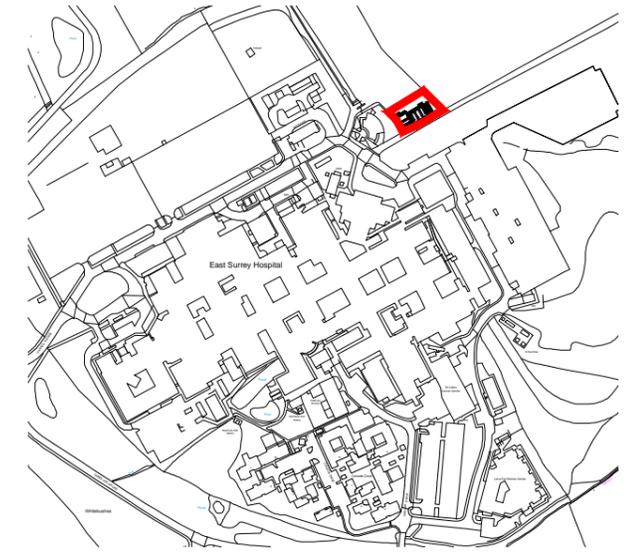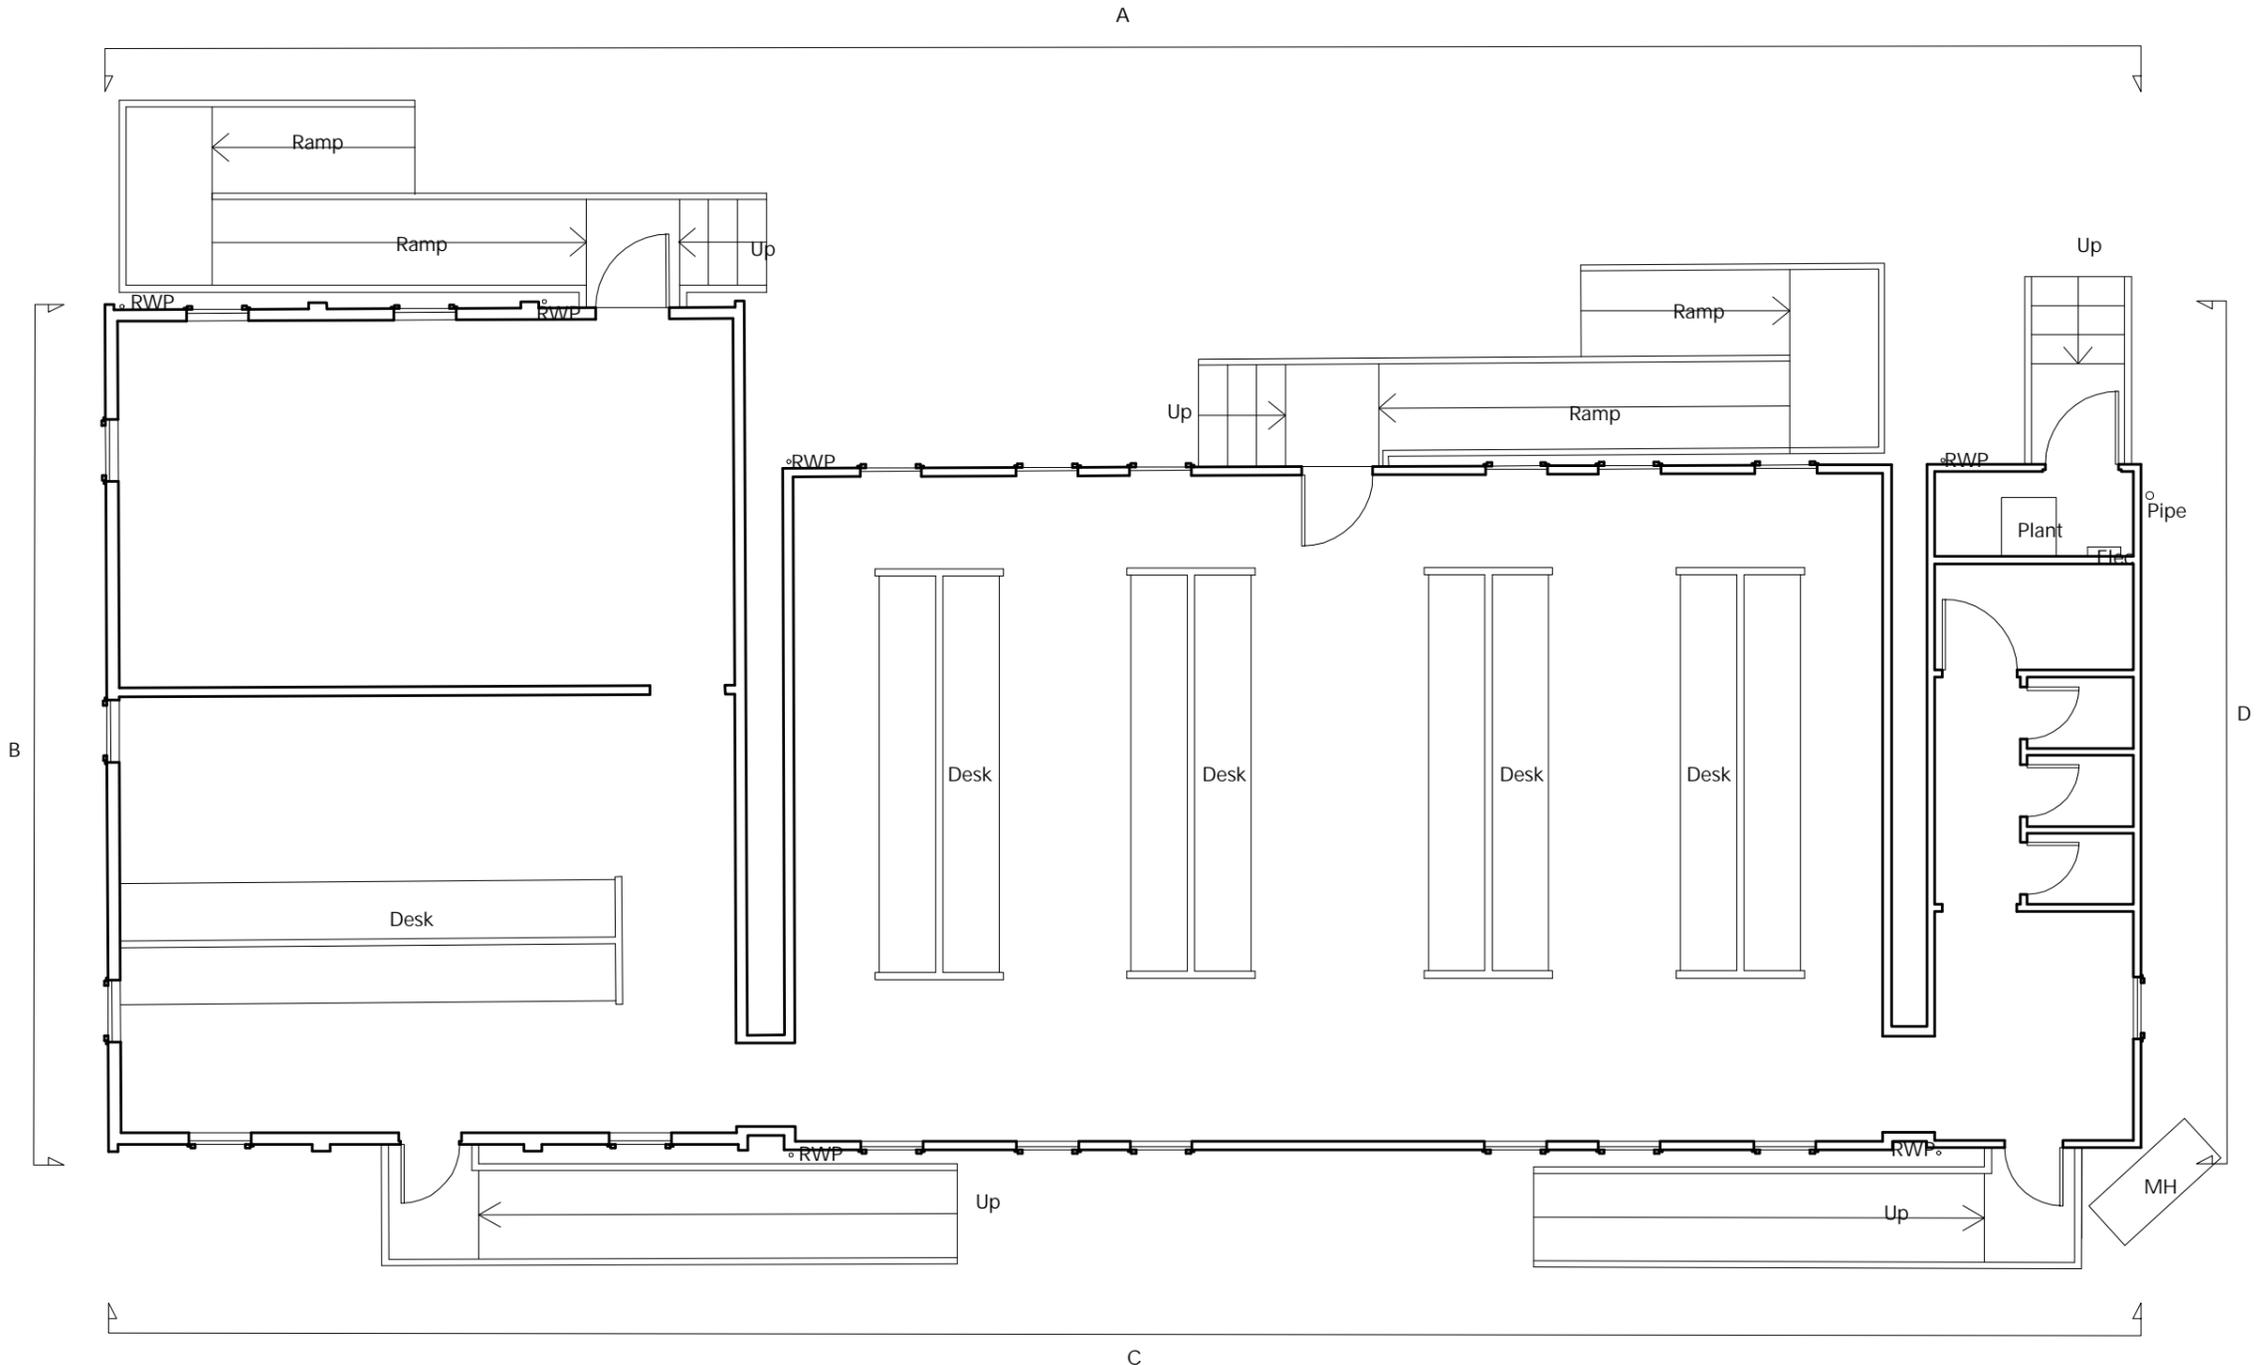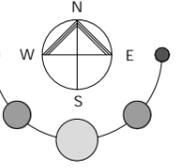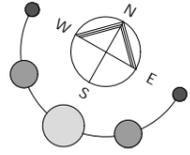

Modular Building Plan
Location Plan NTS

P01	Issued for Planning	24.06.22	AW
rev.	description	date	chkd.

client :
Surrey and Sussex NHS Trust

project :
**East Surrey Hospital
Canada Avenue Redhill, Surrey, RH1 5RH
Retrospective Planning Application**

drawing title :
**Building 41 : New Modular Building
Plan As Built**

Fulkers Bailey Russell

london | brighton | bristol | leeds | reading | manchester
info@fulkers.co.uk // www.fulkers.co.uk // 020 3735 5792

drawn: CK	chkd: AW	date: June 2022
-----------	----------	-----------------


proj no : 22 3623	scale: 1:100 @ A3
--------------------------	----------------------




identifier :
3623-FBR-A10-GF-DR-A-250

status: S4 (For Planning)	rev no: P.01
-------------------------------------	-----------------


Modular Building Plan
As Built

1:100

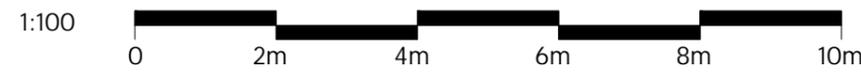


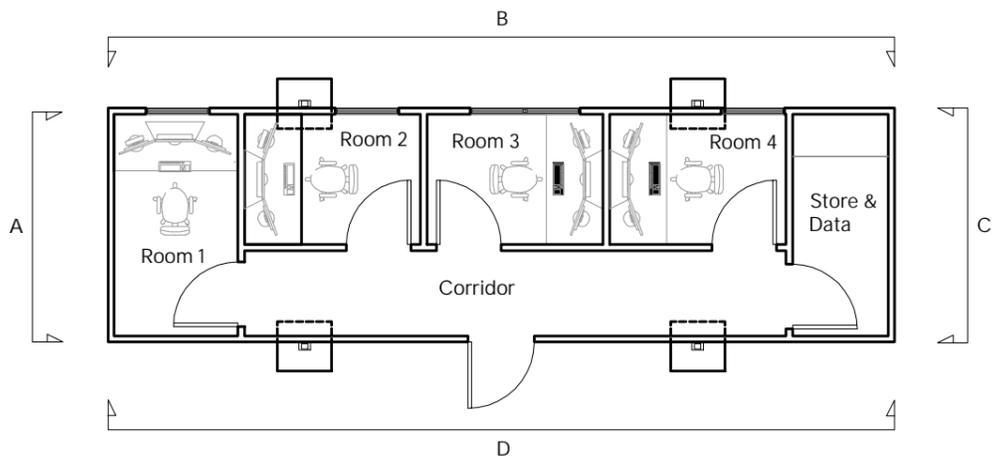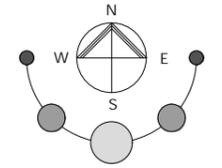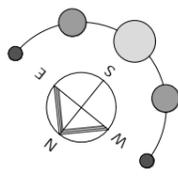


Plan of the MRI Viewing Cabin
As Built 1:100

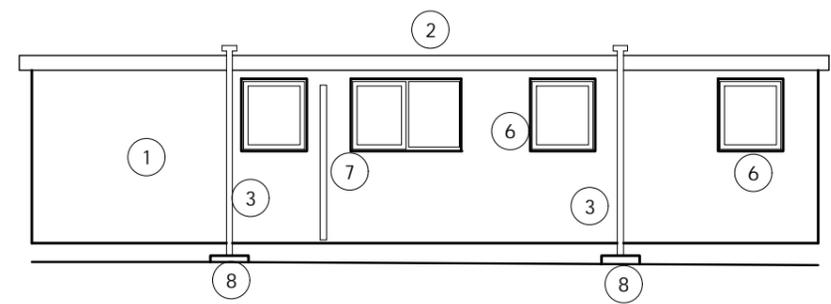


Elevation B
As Built 1:100

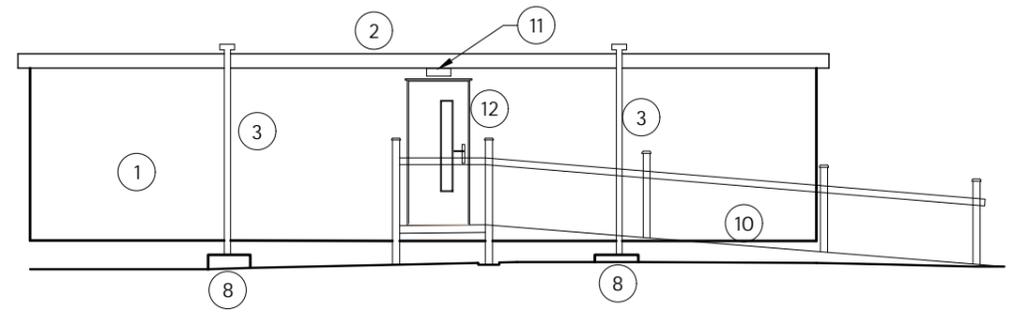

Elevation D
As Built 1:100

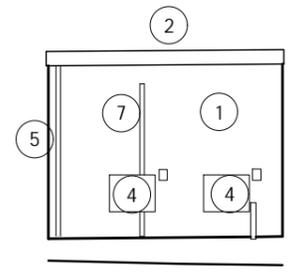


Elevation A
As Built 1:100

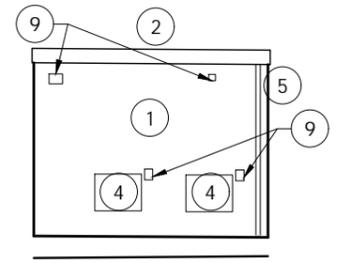

Elevation C
As Built 1:100

KEY TO MATERIALS	
1	Light grey cladding
2	Grey flat roof
3	Metal support for modular building
4	Air conditioning unit
5	White RWP
6	Grey double glazed windows
7	Ducting
8	Concrete support for modular building
9	Electrical points
10	Timber ramp with guardrail
11	Light
12	Dark grey entrance door

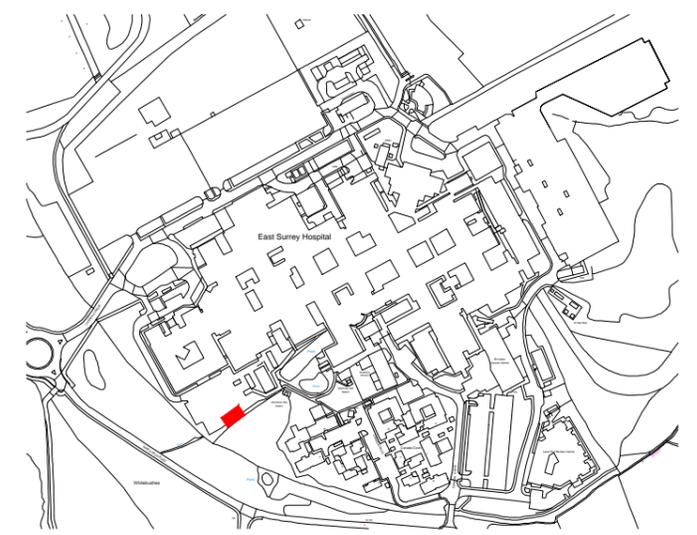

MRI Viewing Cabin
Location Plan NTS

rev.	description	date	chkd.
P01	Issued for Planning	24.06.22	AW

client :
Surrey and Sussex NHS Trust

project :
**East Surrey Hospital
Canada Avenue Redhill, Surrey, RH1 5RH
Retrospective Planning Application**

drawing title :
**Building 37 : MRI Viewing Cabin
Plan and Elevations As Built**


Fulkers Bailey Russell
London | Brighton | Bristol | Leeds | Reading | Manchester
info@fulkers.co.uk // www.fulkers.co.uk // 020 3735 5792


drawn: CK chkd: AW date: June 2022

proj no : **22 3623** scale: 1:100 @ A3

identifier :
3623-FBR-A6-GF-DR-A-230


status: **S4 (For Planning)** rev no: P.01

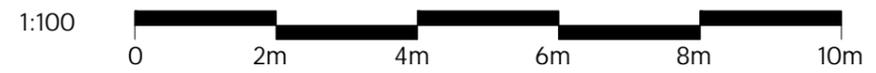

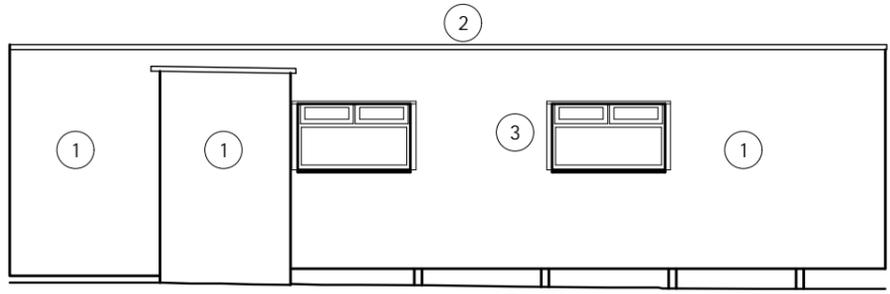


Elevation R of MRI Corridor
As Built

1:100

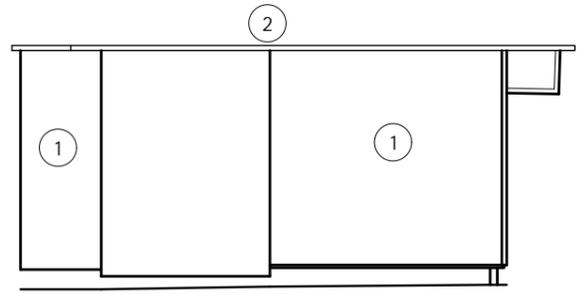


Elevation Q of MRI Corridor
As Built

1:100

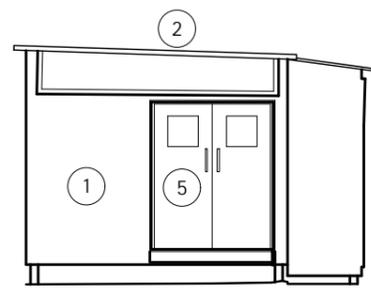

Elevation P of MRI Corridor
As Built


1:100

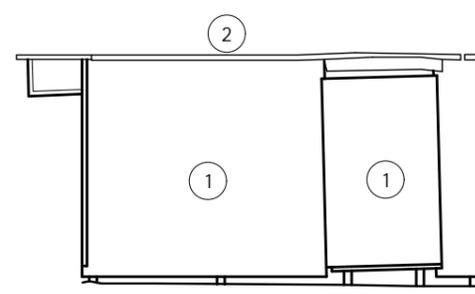

Elevation O of MRI Corridor
As Built


1:100

KEY TO MATERIALS	
1	Light grey cladding
2	Grey flat roof
3	White double glazed windows
4	Light
5	White entrance door

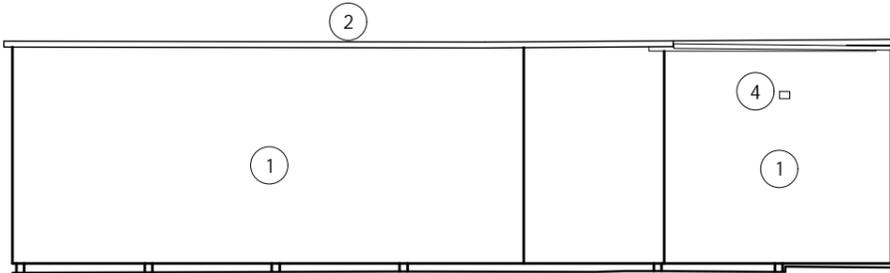

Elevation N of MRI Corridor
As Built

1:100

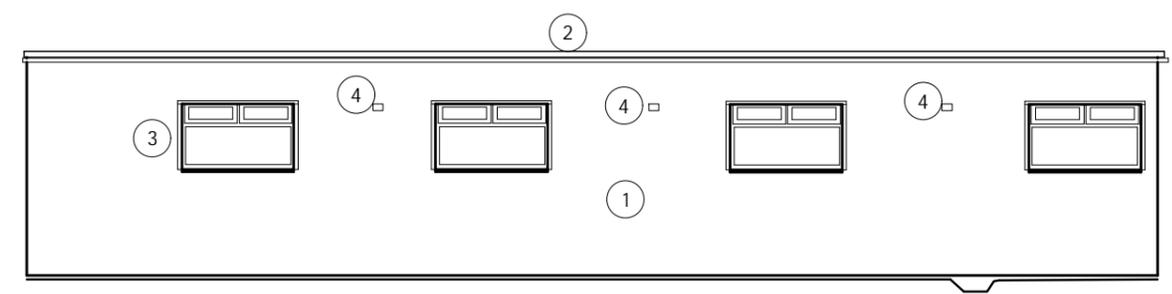

Elevation M of MRI Corridor
As Built

1:100

P01 Issued for Planning 24.06.22 AW

rev.	description	date	chkd.

client :
Surrey and Sussex NHS Trust

project :
East Surrey Hospital
Canada Avenue Redhill, Surrey, RH1 5RH
Retrospective Planning Application

drawing title :
Building 34 : Corridor to Temporary MRI
Elevations M to R As Built

Fulkers Bailey Russell

London | Brighton | Bristol | Leeds | Reading | Manchester
info@fulkers.co.uk // www.fulkers.co.uk // 020 3735 5792


drawn: CK chkd: AW date: June 2022

proj no: 22 3623 scale: 1:100 @ A3

identifier :
3623-FBR-A3-GF-DR-A-217


status: S4 (For Planning) rev no: P.01



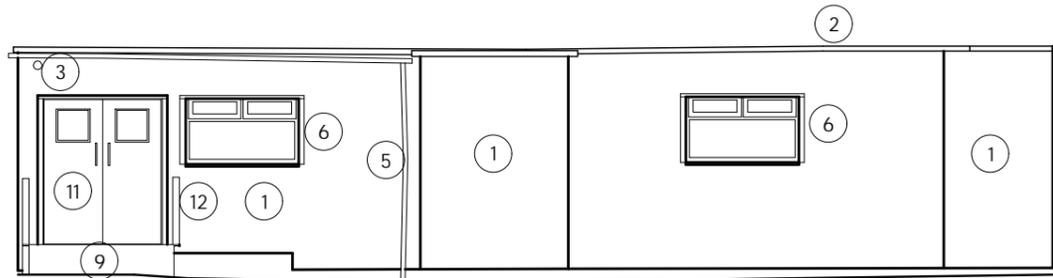


Elevation Y of MRI Corridor
As Built

1:100

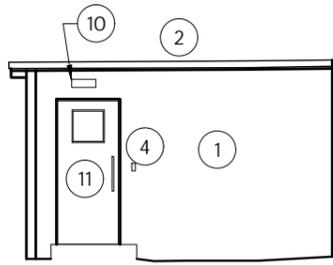

Elevation W of Corridor
As Built

1:100

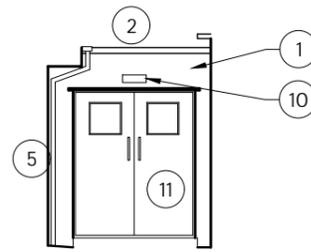


Elevation V
As Built

1:100


KEY TO MATERIALS

- ① Light grey cladding
- ② Grey flat roof
- ③ Camera
- ④ Card scan
- ⑤ White RWP
- ⑥ White double glazed windows
- ⑦ Iron railings
- ⑧ brick dwarf wall
- ⑨ Ramp
- ⑩ Light
- ⑪ White entrance door
- ⑫ Guard rails

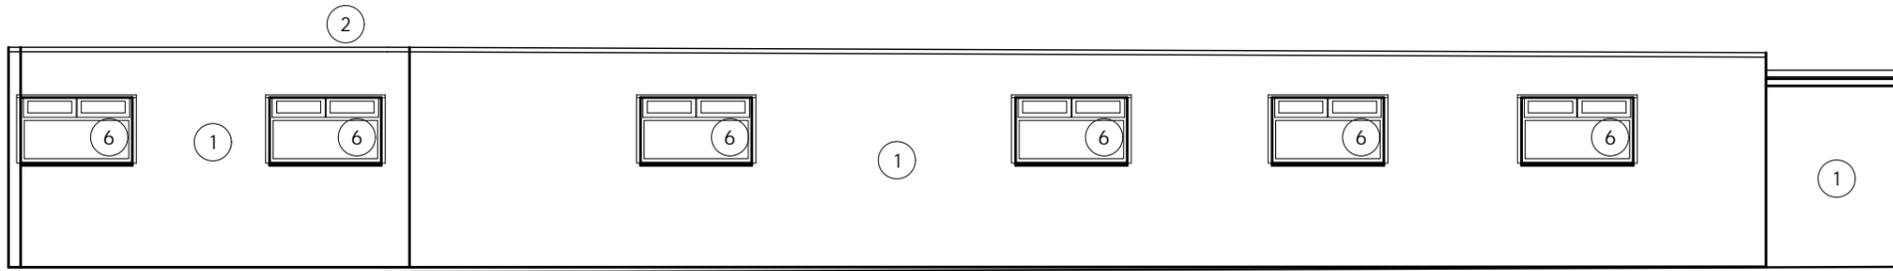


Elevation X of MRI Corridor
As Built

1:100

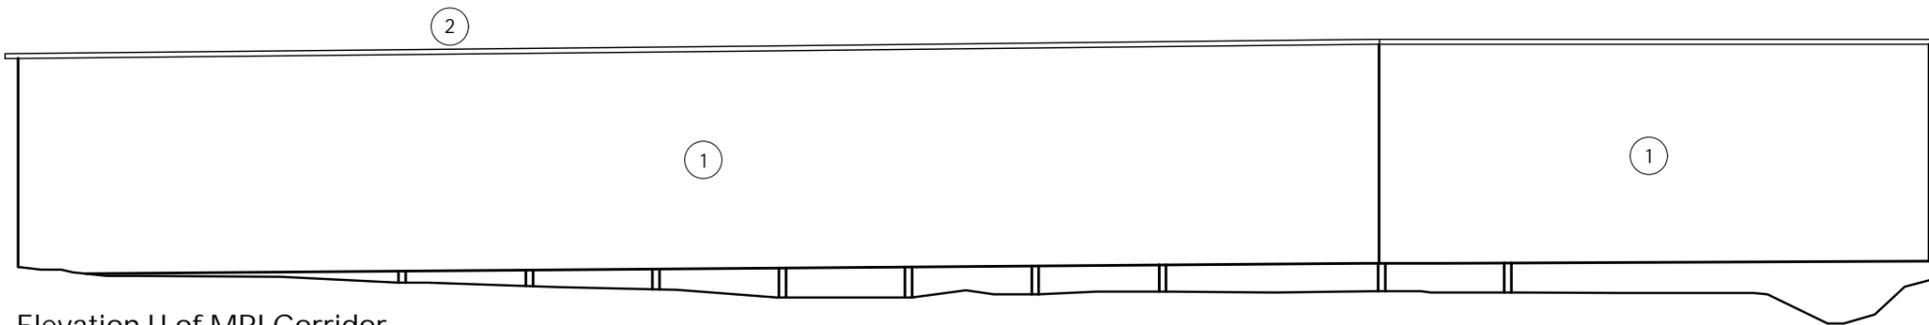


Elevation U of MRI Corridor
As Built

1:100

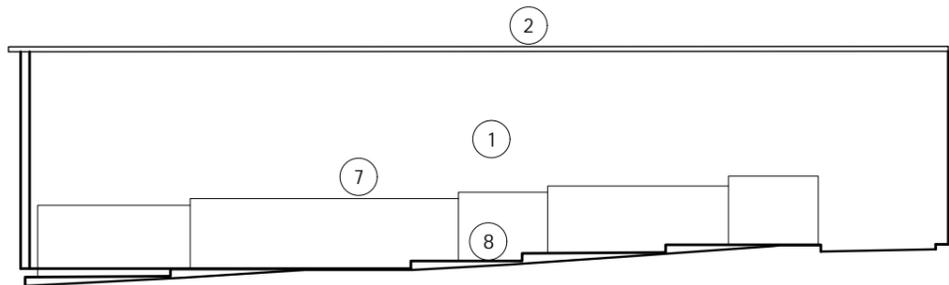

Elevation T of MRI Corridor
As Built

1:100

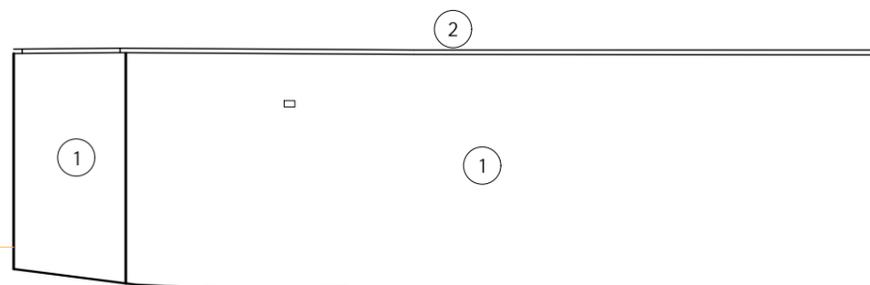

Elevation S of MRI Corridor
As Built

1:100

1:100



P01	Issued for planning	24.06.22	AW
rev.	description	date	chkd.

client :

Surrey and Sussex NHS Trust

project :

East Surrey Hospital
Canada Avenue Redhill, Surrey, RH1 5RH
Retrospective Planning Application

drawing title :

Building 34 : Corridor to Temporary MRI
Elevations S TO Y As Built

Fulkers Bailey Russell


London | Brighton | Bristol | Leeds | Reading | Manchester
info@fulkers.co.uk // www.fulkers.co.uk // 020 3735 5792

drawn: CK	chkd: AW	date: June 2022
-----------	----------	-----------------

proj no : 22 3623	scale: 1:100 @ A3
-------------------	-------------------


identifier : 3623-FBR-A3-GF-DR-A-216

status: S4 (For Planning)	rev no: P.01
---------------------------	--------------

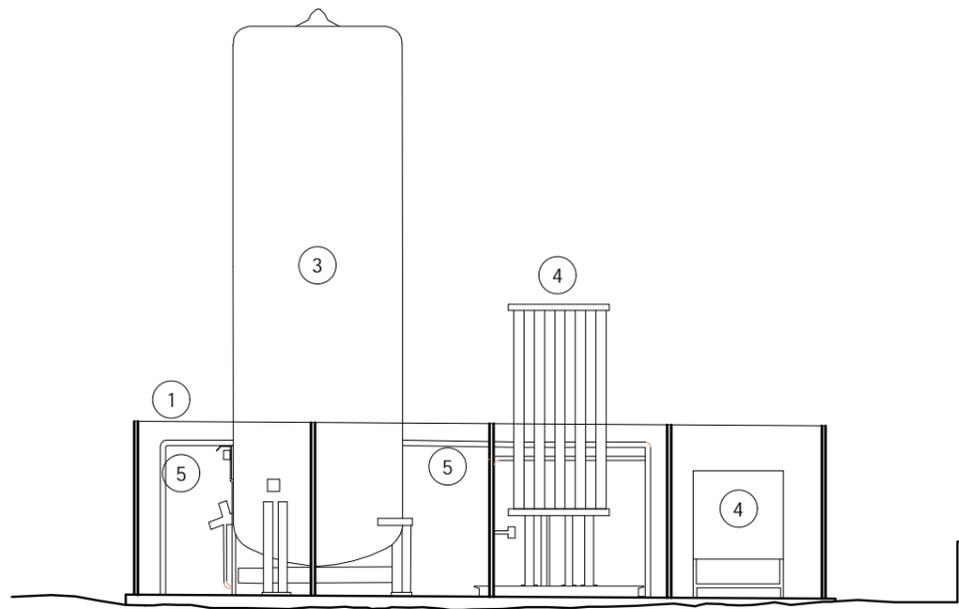

Elevation A
As Built


1:100

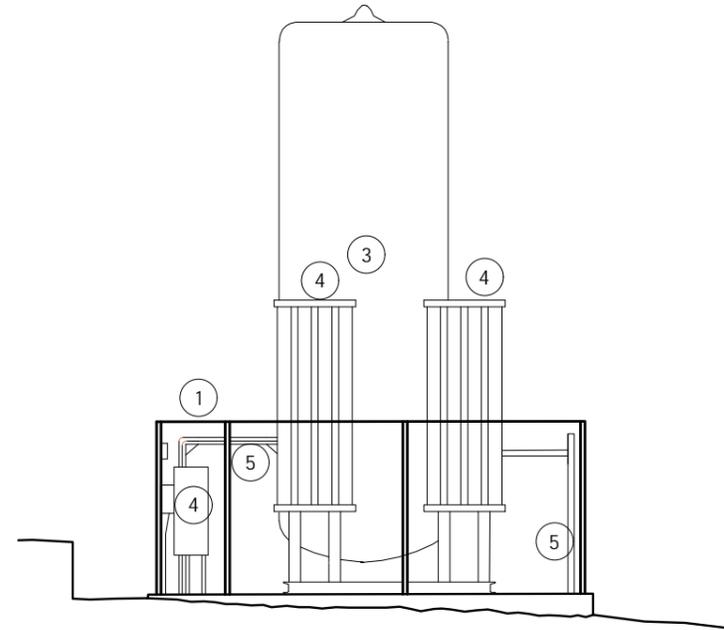

Elevation B
As Built


1:100

KEY TO MATERIALS	
1	Metal fence
2	Metal gate
3	Tank
4	Plant
5	Plant pipes

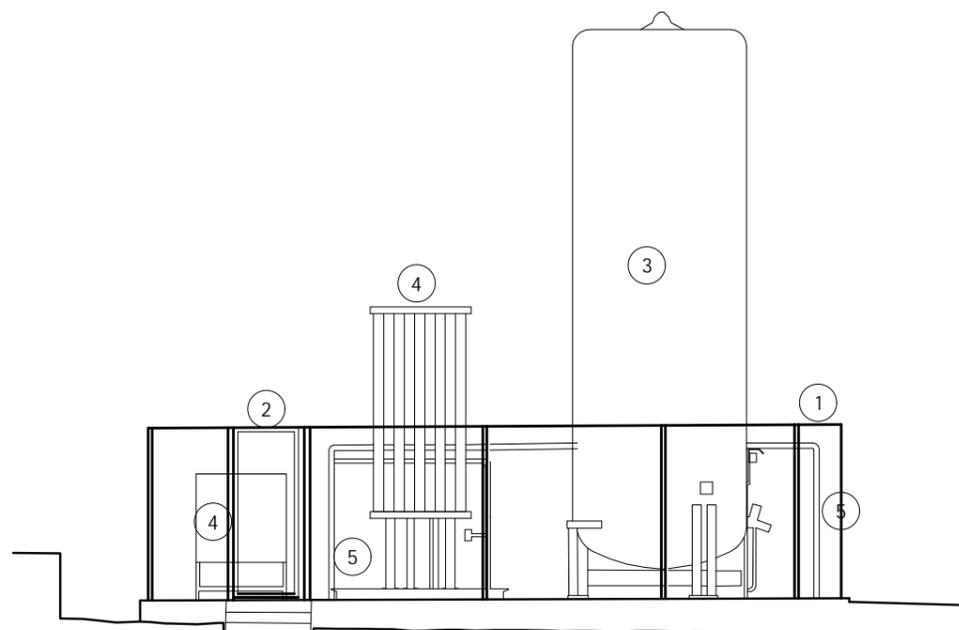

Elevation C
As Built

1:100

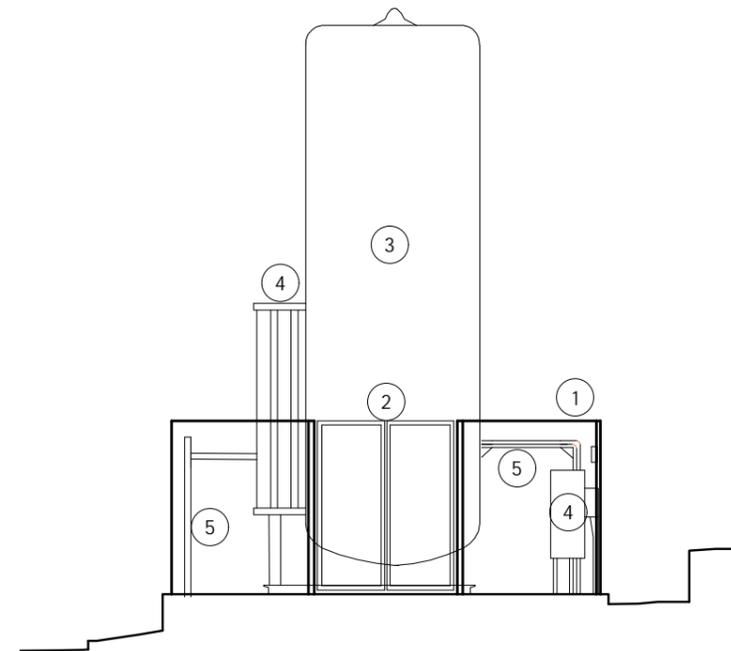

Elevation D
As Built

1:100



P01	Issued for Planning	24.06.22	AW
rev.	description	date	chkd.

client :

Surrey and Sussex NHS Trust

project :

East Surrey Hospital
Canada Avenue Redhill, Surrey, RH1 5RH
Retrospective Planning Application

drawing title :

Building 39 : New VIE and Compound
Elevations As Built

Fulkers Bailey Russell

London | Brighton | Bristol | Leeds | Reading | Manchester
info@fulkers.co.uk // www.fulkers.co.uk // 020 3735 5792


drawn: CK	chkd: AW	date: June 2022
-----------	----------	-----------------

proj no: 22 3623	scale: 1:100 @ A3
------------------	-------------------

identifier :

3623-FBR-A8-GF-DR-A-241

status: S4 (For Planning)	rev no: P.01
---------------------------	--------------

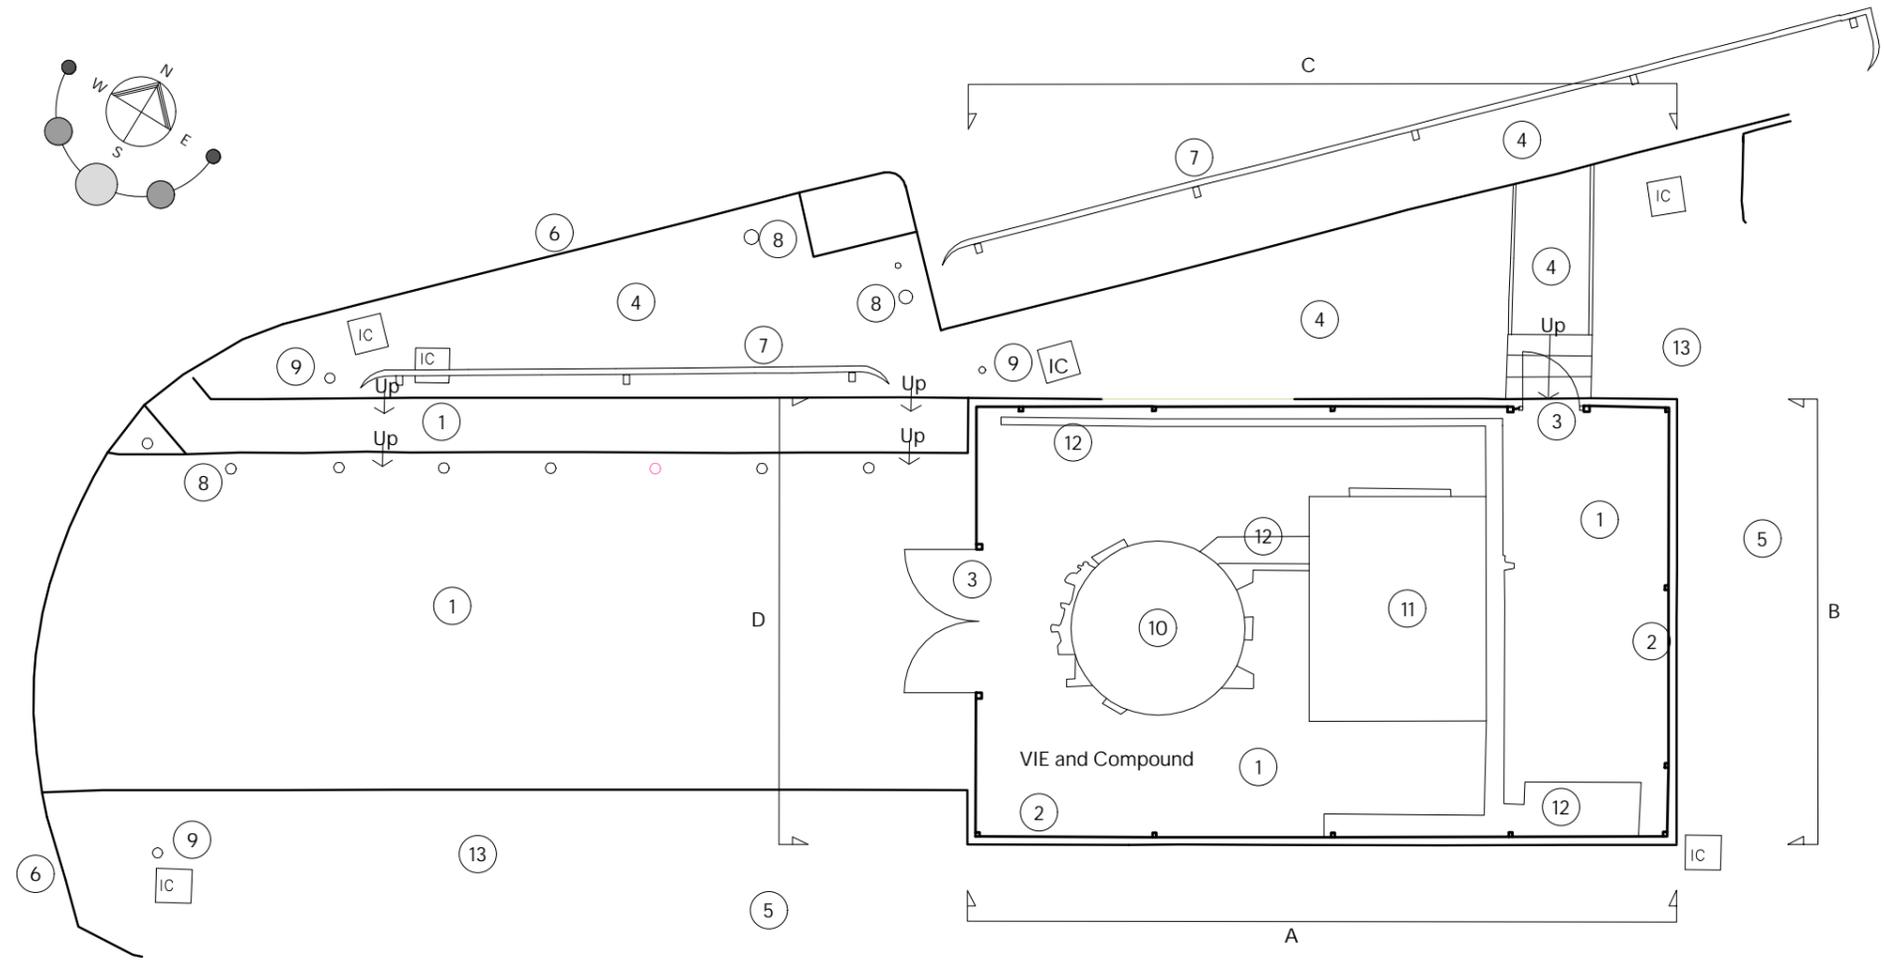


VIE and Compound Plan

As Built

1:100

KEY TO MATERIALS	
①	Concrete
②	Metal fence
③	Metal gate
④	Tarmacadam finish
⑤	Gabion baskets
⑥	Kerb
⑦	Crash barrier
⑧	Bollard
⑨	Lamp post
⑩	Tank
⑪	Plant
⑫	Plant pipes
⑬	Pebbles

1:100

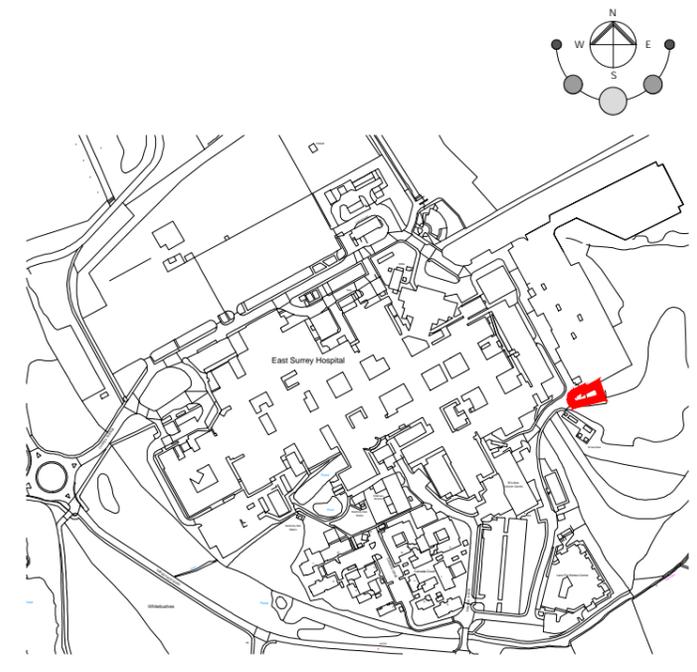

VIE and Compound

Location Plan

NTS

rev.	description	date	chkd.
P01	Issued for Planning	24.06.22	AW

client :

Surrey and Sussex NHS Trust

project :

East Surrey Hospital
Canada Avenue Redhill, Surrey, RH1 5RH
Retrospective Planning Application

drawing title :

Building 39 : New VIE and Compound
Plan As Built

Fulkers Bailey Russell


London | Brighton | Bristol | Leeds | Reading | Manchester
info@fulkers.co.uk // www.fulkers.co.uk // 020 3735 5792

drawn: CK	chkd: AW	date: June 2022
-----------	----------	-----------------

proj no : 22 3623	scale: 1:100 @ A3
-------------------	-------------------

identifier : 3623-FBR-A8-GF-DR-A-240


status: S4 (For Planning)	rev no: P.01
---------------------------	--------------

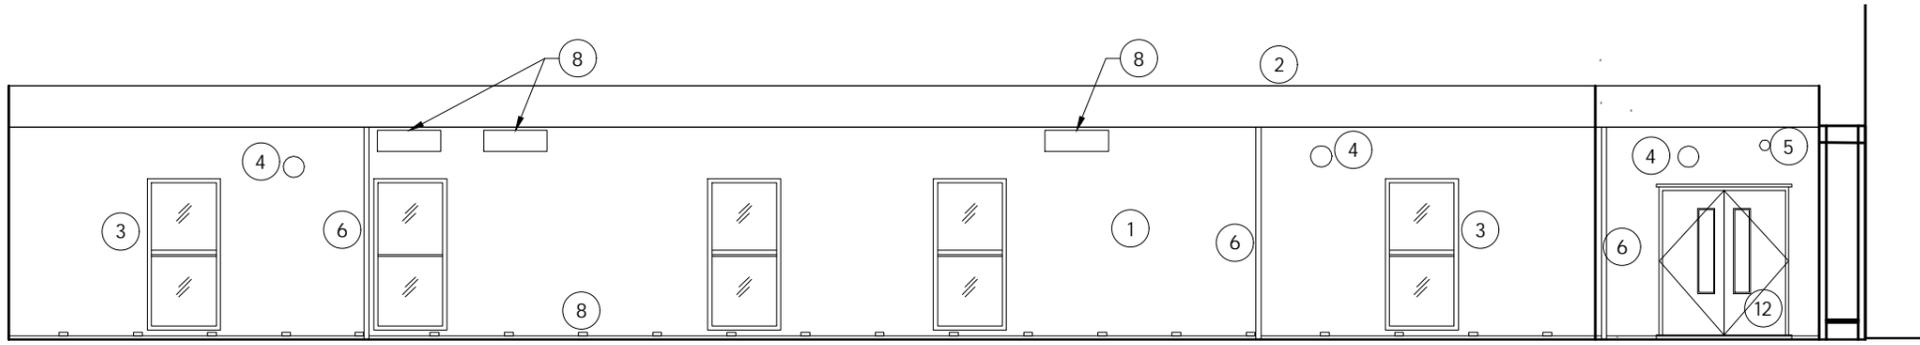

Elevation A of Smallfield Ward

As Built


1:100

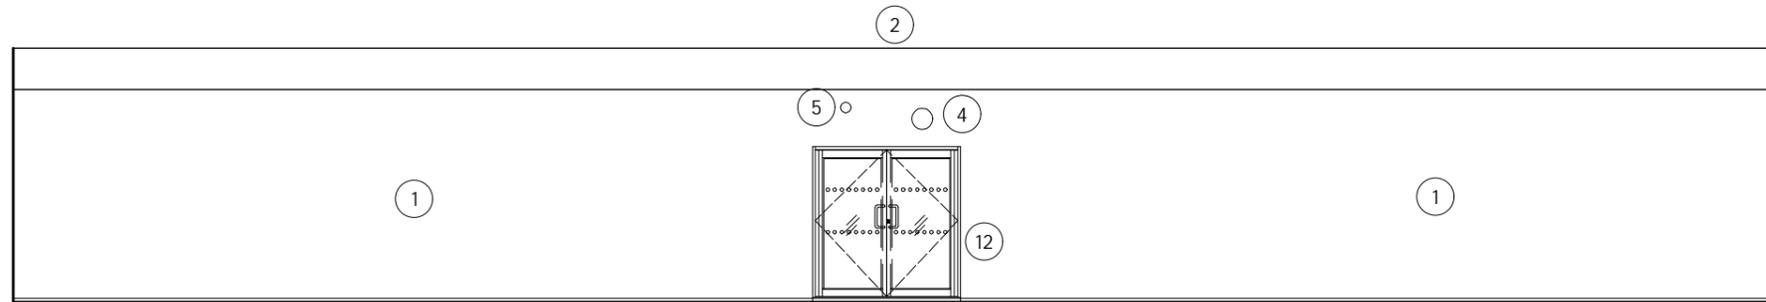

Elevation B of Smallfield Ward

As Built


1:100

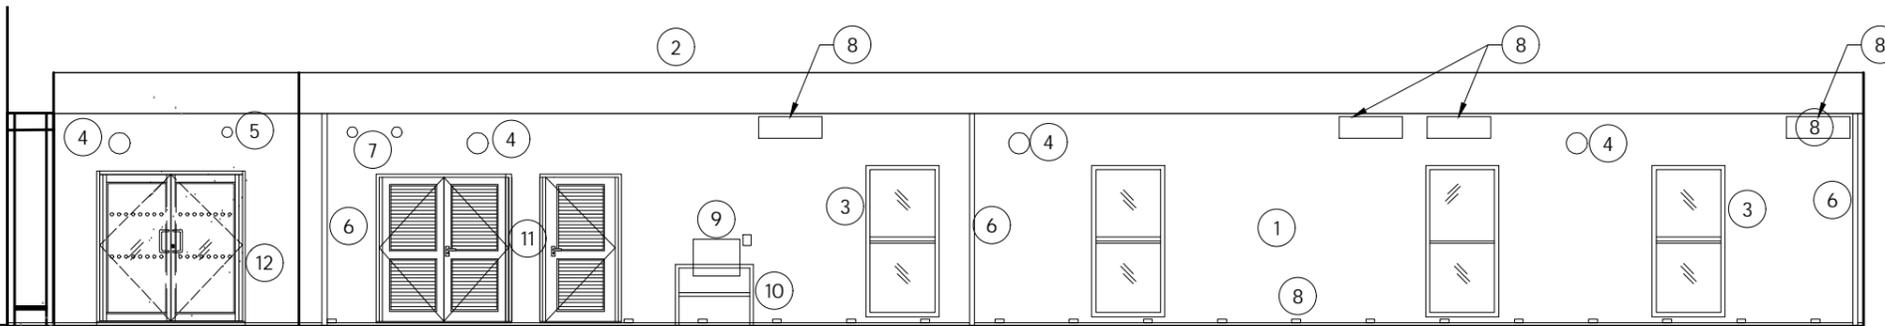

Elevation C of Smallfield Ward

As Built

1:100

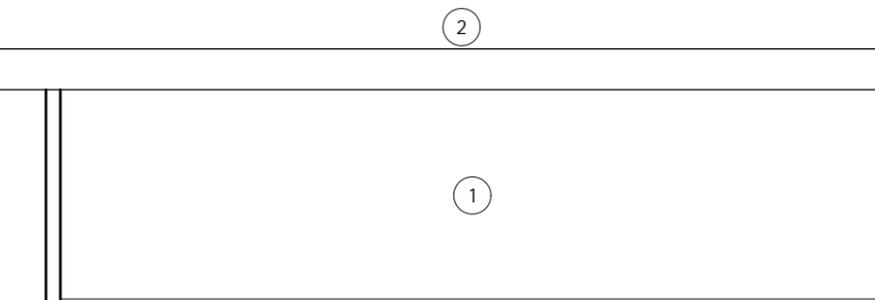

Elevation D of Smallfield Ward

As Built

1:100

KEY TO MATERIALS	
1	Blue and grey cladding
2	Dark grey flat roof
3	Dark grey double glazed windows
4	light
5	Camera
6	Dark grey rwp
7	Extract
8	Vents
9	Air conditioning unit
10	Guardrail
11	Dark grey plant doors
12	Dark grey entrance doors

rev.	description	date	chkd.
P01	Issued for Planning	24.06.22	AW

client :

Surrey and Sussex NHS Trust

project :

East Surrey Hospital
Canada Avenue Redhill, Surrey, RH1 5RH
Retrospective Planning Application

drawing title :

Building 36 : Smallfield Ward
Elevations As Built

Fulkers Bailey Russell

london | brighton | bristol | leeds | reading | manchester
info@fulkers.co.uk // www.fulkers.co.uk // 020 3735 5792



drawn: CK	chkd: AW	date: June 2022
-----------	----------	-----------------

proj no: 22 3623	scale: 1:100 @ A3
------------------	-------------------

identifier : 3623-FBR-A5-GF-DR-A-226

status: S4 (For Planning)	rev no: P.01
---------------------------	--------------



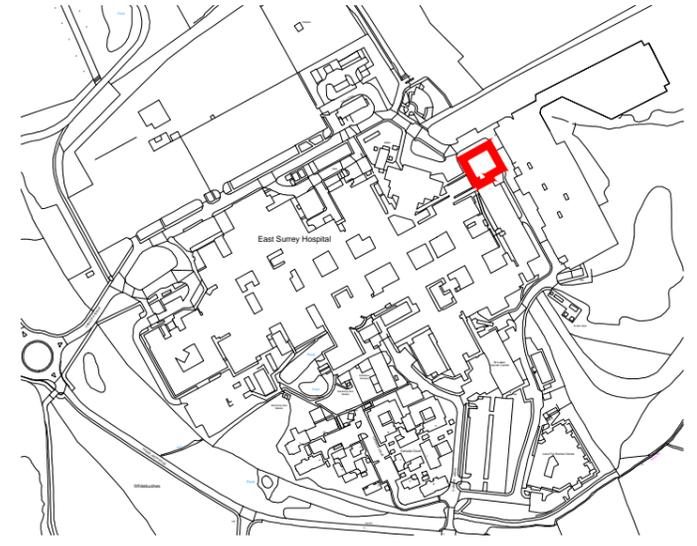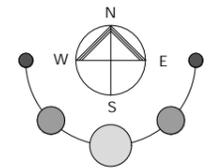

Smallfield Ward
Location Plan
NTS

P01	Issued for Planning	24.06.22	AW
rev.	description	date	chkd.

client :
Surrey and Sussex NHS Trust

project :
**East Surrey Hospital
Canada Avenue Redhill, Surrey, RH1 5RH
Retrospective Planning Application**

drawing title :
**Building 36 : Smallfield Ward
Plan As Built**

Fulkers Bailey Russell


London | Brighton | Bristol | Leeds | Reading | Manchester
info@fulkers.co.uk // www.fulkers.co.uk // 020 3735 5792

drawn: CK	chkd: AW	date: June 2022
-----------	----------	-----------------

proj no : 22 3623	scale: 1:100 @ A3
-------------------	-------------------

identifier :
3623-FBR-A5-GF-DR-A-225

status: S4 (For Planning)	rev no: P.01
----------------------------------	--------------

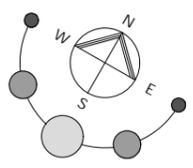

Smallfield Ward Plan
As Built



1:100

APPENDIX A: PHOTOS OF THE BUILDINGS AND CAR PARKS



Building 15 Discharge Unit front view



Building 15A Changing Space side view



Building 34 MRI Corridor



Building 34 MRI Corridor



Building 35 Kiasen Office



Building 36 Smallfield Ward



Building 37 MRI Viewing Cabin



Building 38 Dietetics Officer back view




Building 39 VIE & Compound front



Building 41 Modular Offices



Accessible Car Park

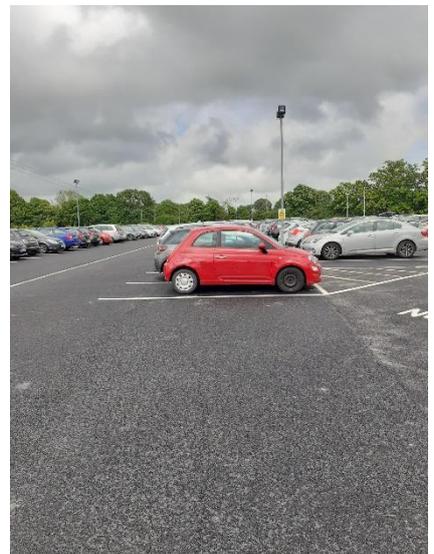

Overflow Car Park